
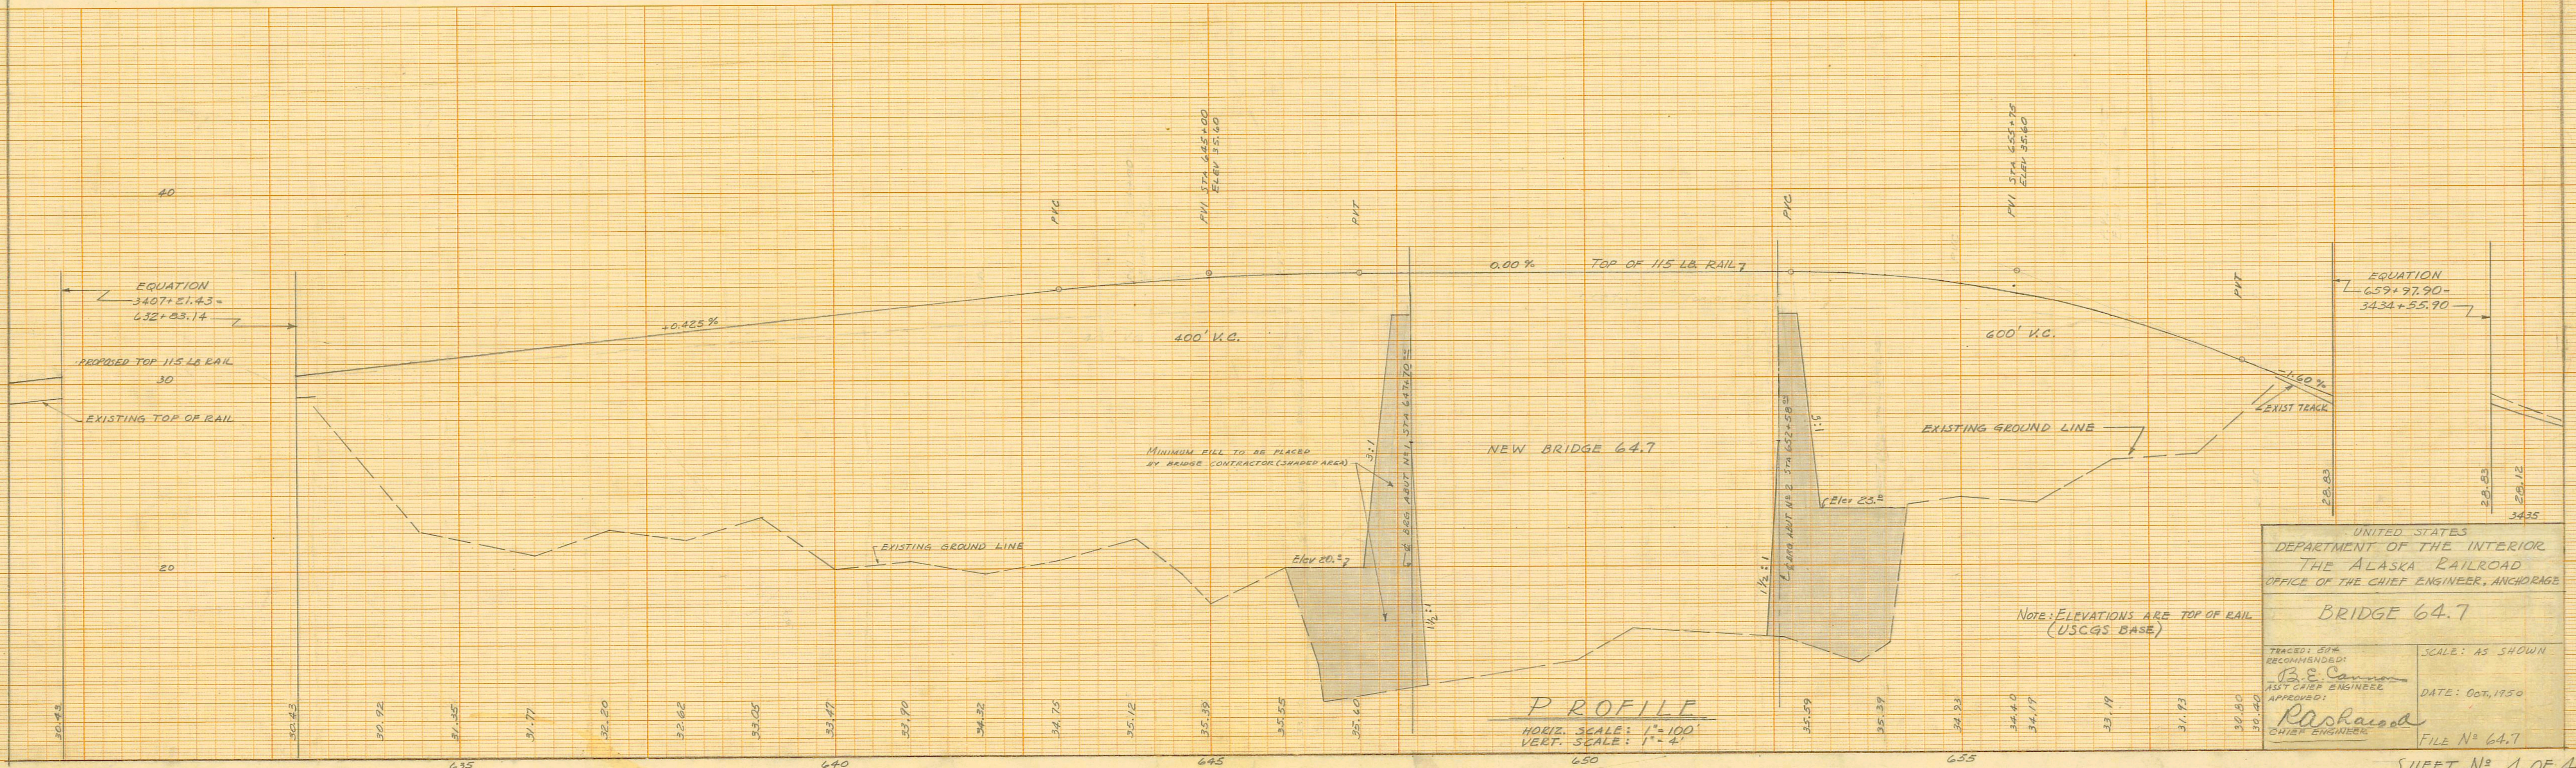


M.L. EQUATION
 $659+97.70 =$
 $3434+55.70$

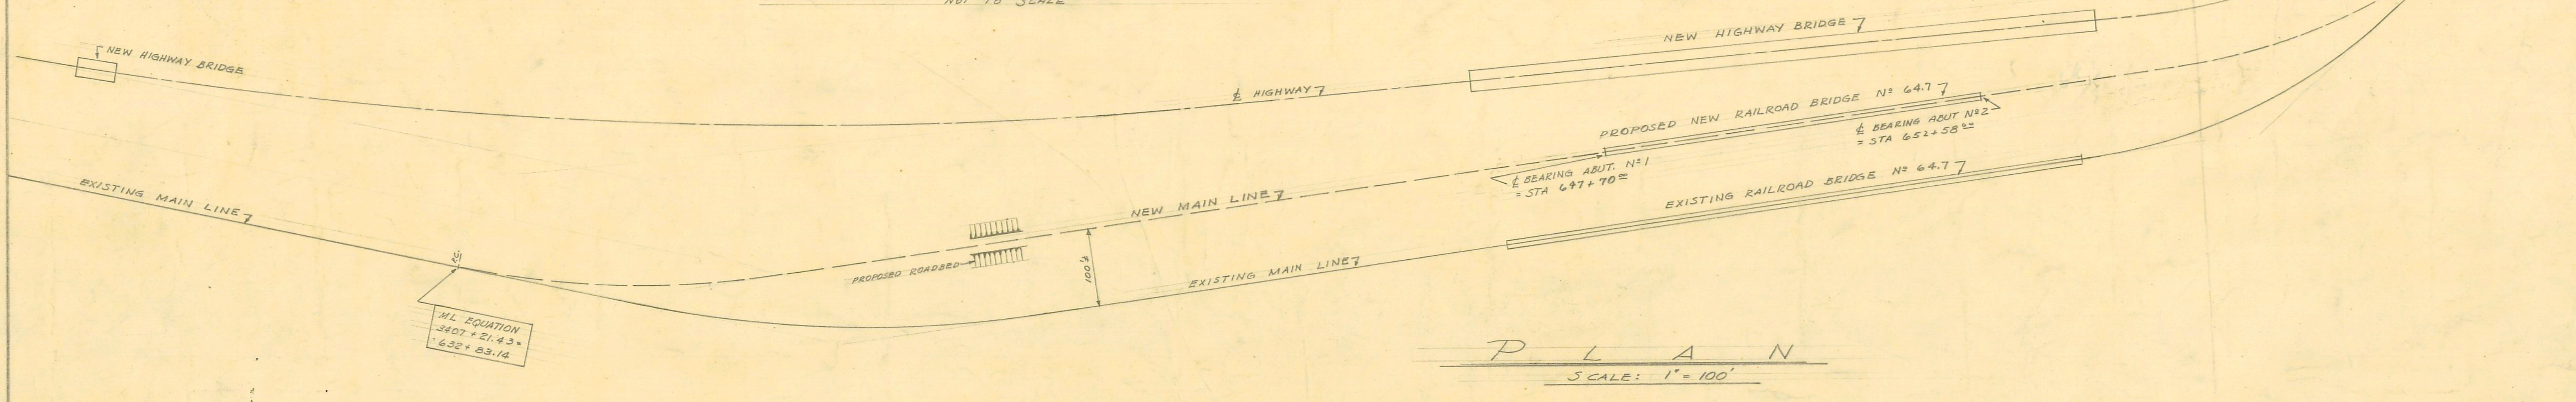


UNITED STATES
 DEPARTMENT OF THE INTERIOR
 THE ALASKA RAILROAD
 OFFICE OF THE CHIEF ENGINEER, ANCHORAGE



BRIDGE 64.7

TRACED, COR. RECOMMENDED BY
R. E. Cannon
 ASST. CHIEF ENGINEER
 APPROVED:
Raskard
 CHIEF ENGINEER

SCALE: AS SHOWN
 DATE: Oct. 1950
 FILE No. 64.7

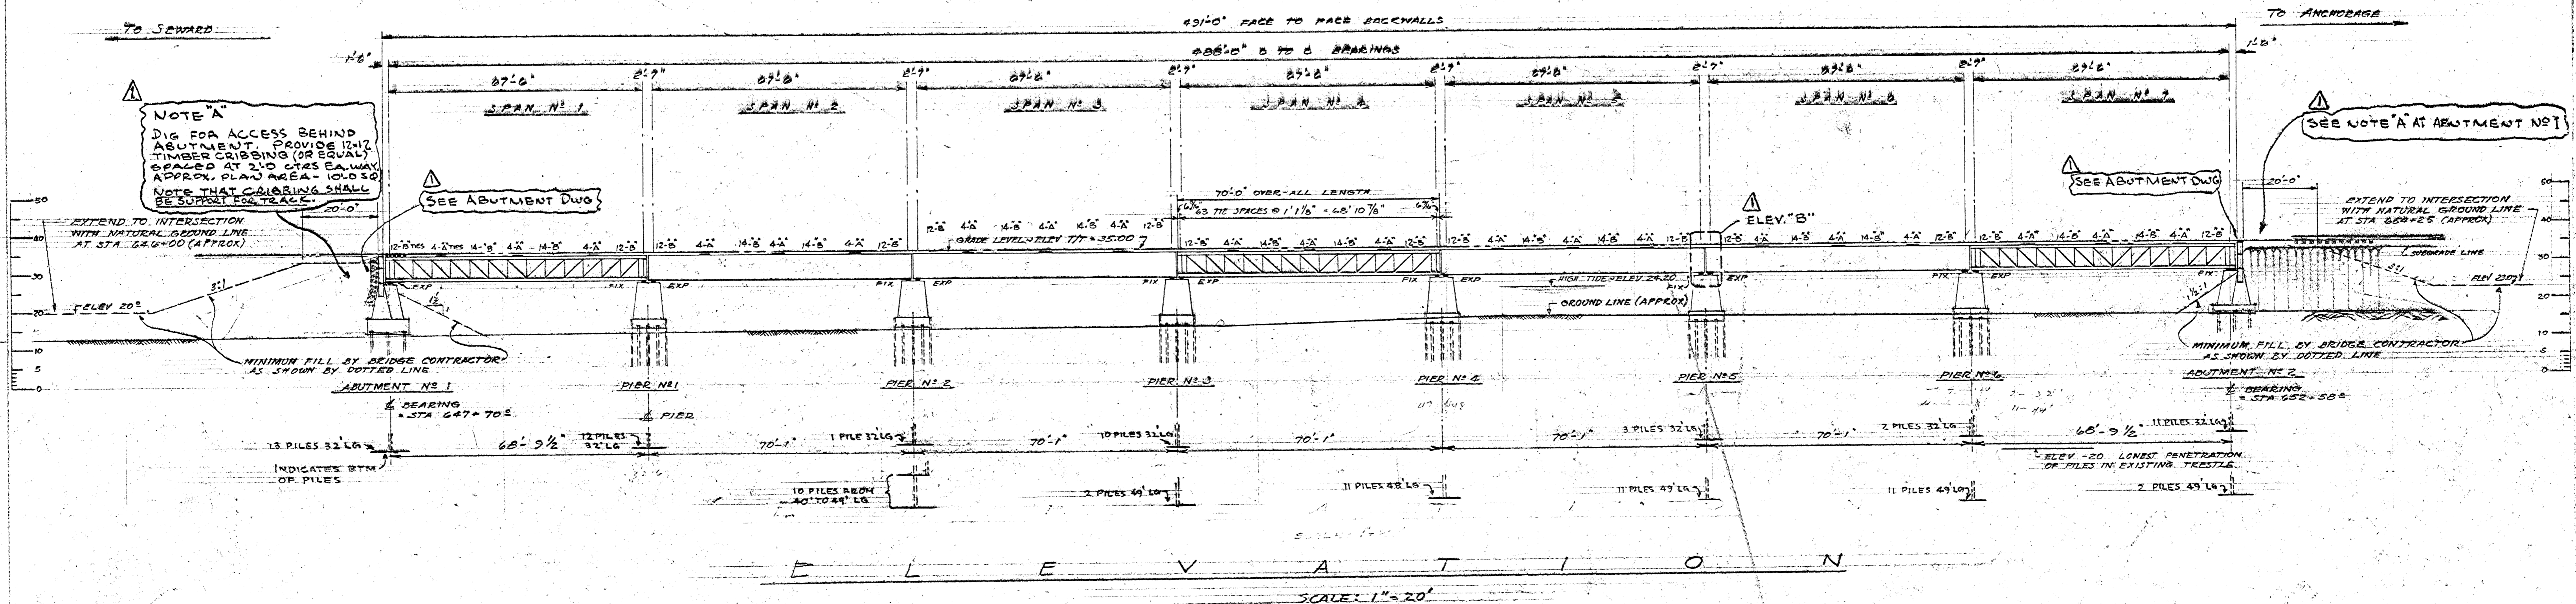

- WORK AT PIER NO 5**
ORDER OF PROCEDURE
1. ALIGN TRUSSES & JOIN WITH PLATES WELDED TO END POSTS. SEE ELEV. "B"
 2. JACK UP BOTH TRUSSES (JOINED TOGETHER) SEE JACKING ARRANGEMENT
 3. REMOVE EXISTING BED PLATES.
 4. TRIM ANCHOR BOLTS WHICH SHEARED OFF SO THEY CAN BE PLUG WELDED TO NEW BASE PLATE.
 5. CUT DOWN 3 EXISTING BED PLATES & WELD TO NEW BED PLATES. SEE BASE PLAN.
 6. SET NEW BED PLATES IN "EMBECCO" GROUT. ALLOW TO SET FOR 3 DAYS BEFORE RELEASING JACKS. GROUT SHALL BE COVERED WITH INSULATING BLANKETS DURING CURING PERIOD.


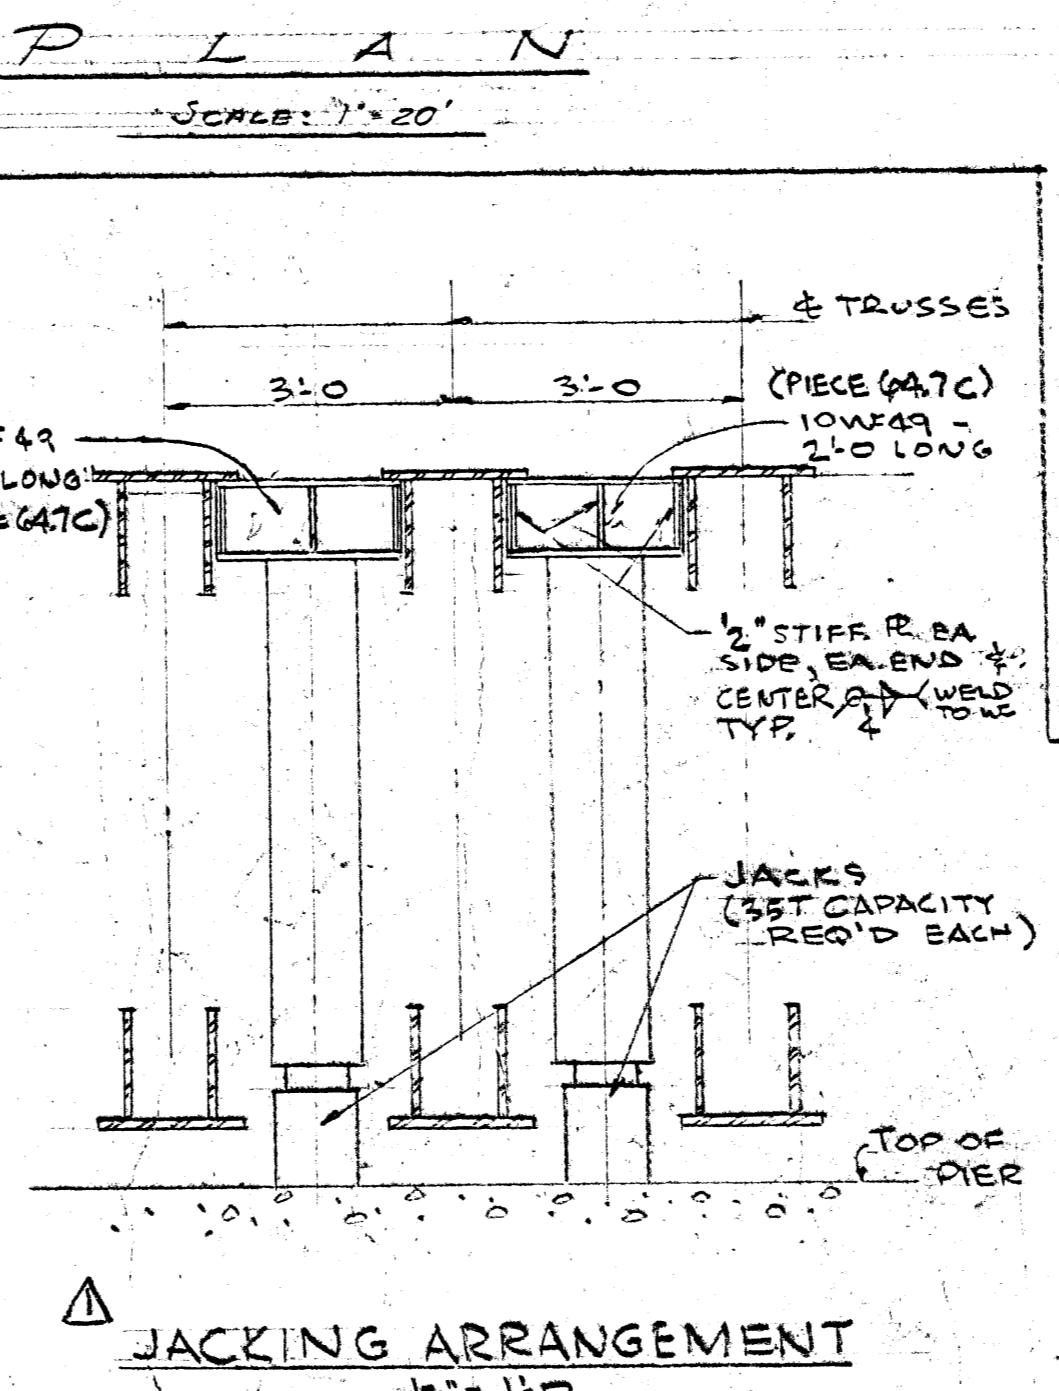
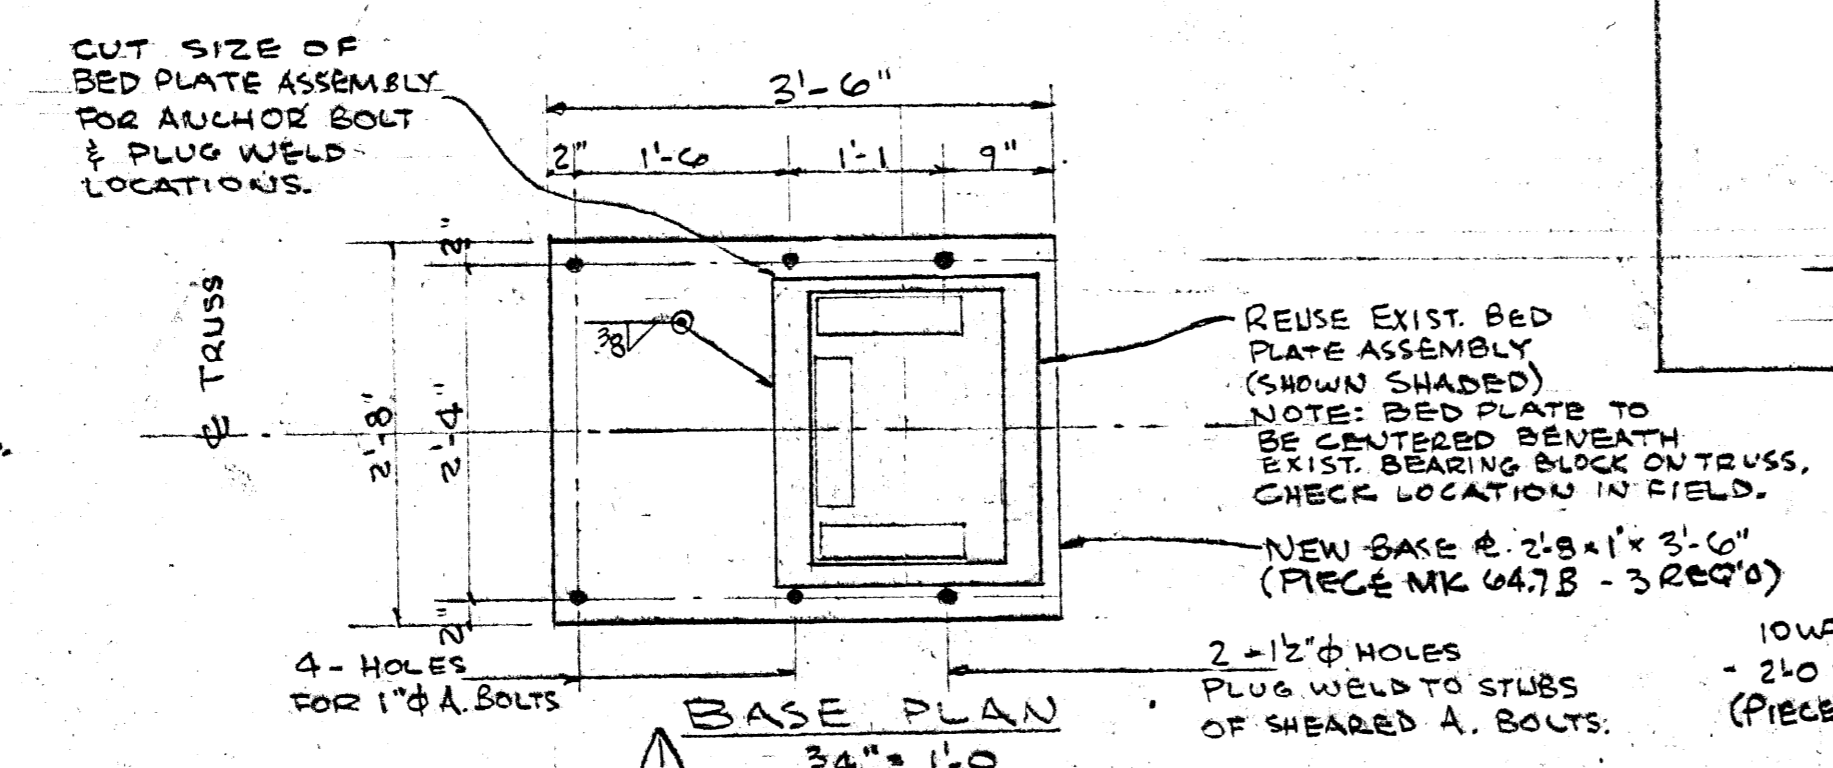


SUMMARY OF ESTIMATED QUANTITIES (APPROX)

EXCAVATION	300 CY
CONCRETE	500 CY
TRUSS STEEL	3.1 TONS
FOUNDATION PILES - 88'-0" LONG (SEE DETAIL)	101 TONS
CAP PLATES FOR PILES	1.8 TONS
STEEL SHEET PILING (COFFERDAMS)	86.2 TONS
STRUCTURAL STEEL	348.25 TONS
TIES 329 - 8"x10"x12'-0"	20.7 MRF
119 - 8"x10"x12'-0"	12.2 MRF
LUMBER IN WALKS & BARREL STANDS	11.5 MRF
GORED BRK 4"x8" 1000 LP	2.67 MRF

NOTE:
BOTH ABUTMENTS ALIKE EXCEPT FOR DEPTH OF FOOTINGS
ALL PIERS ALIKE

WT OF STEEL PER SPAN APPROX. 4975 TON
WT OF ONE GIRDER 13.9 TON
TOTAL WT OF STEEL IN SUPERSTRUCTURE 380.25 TON

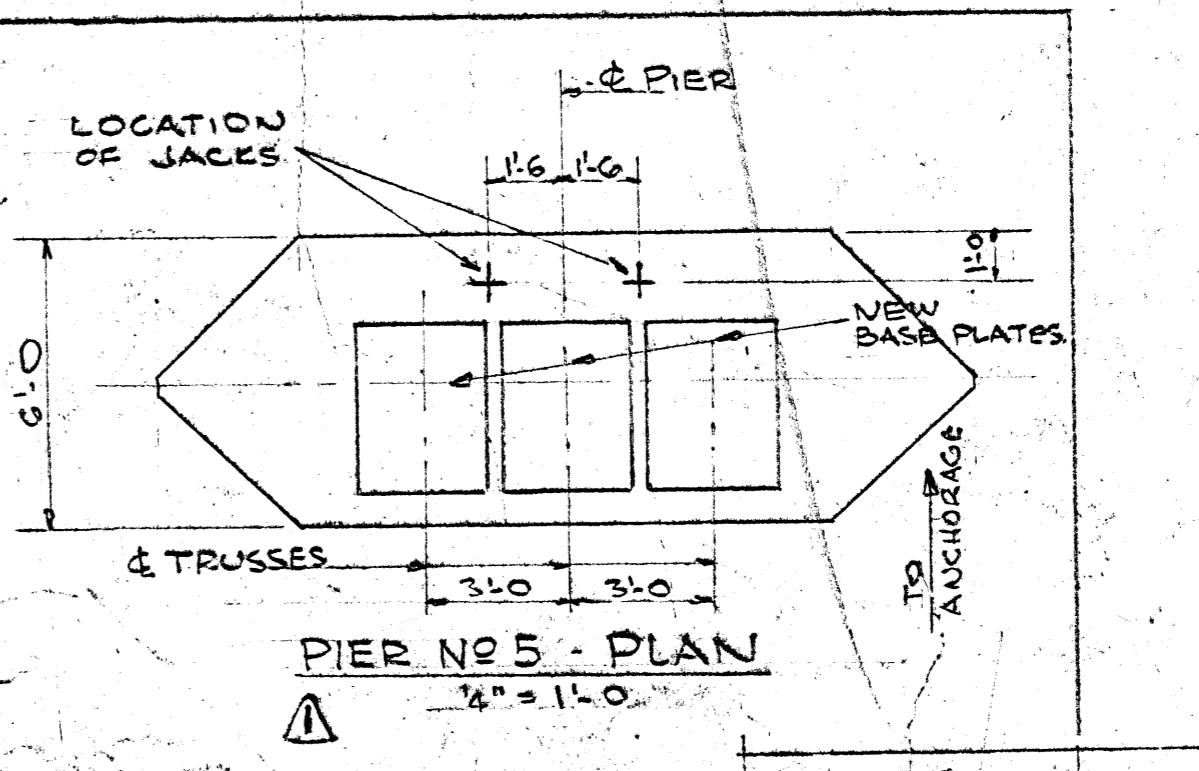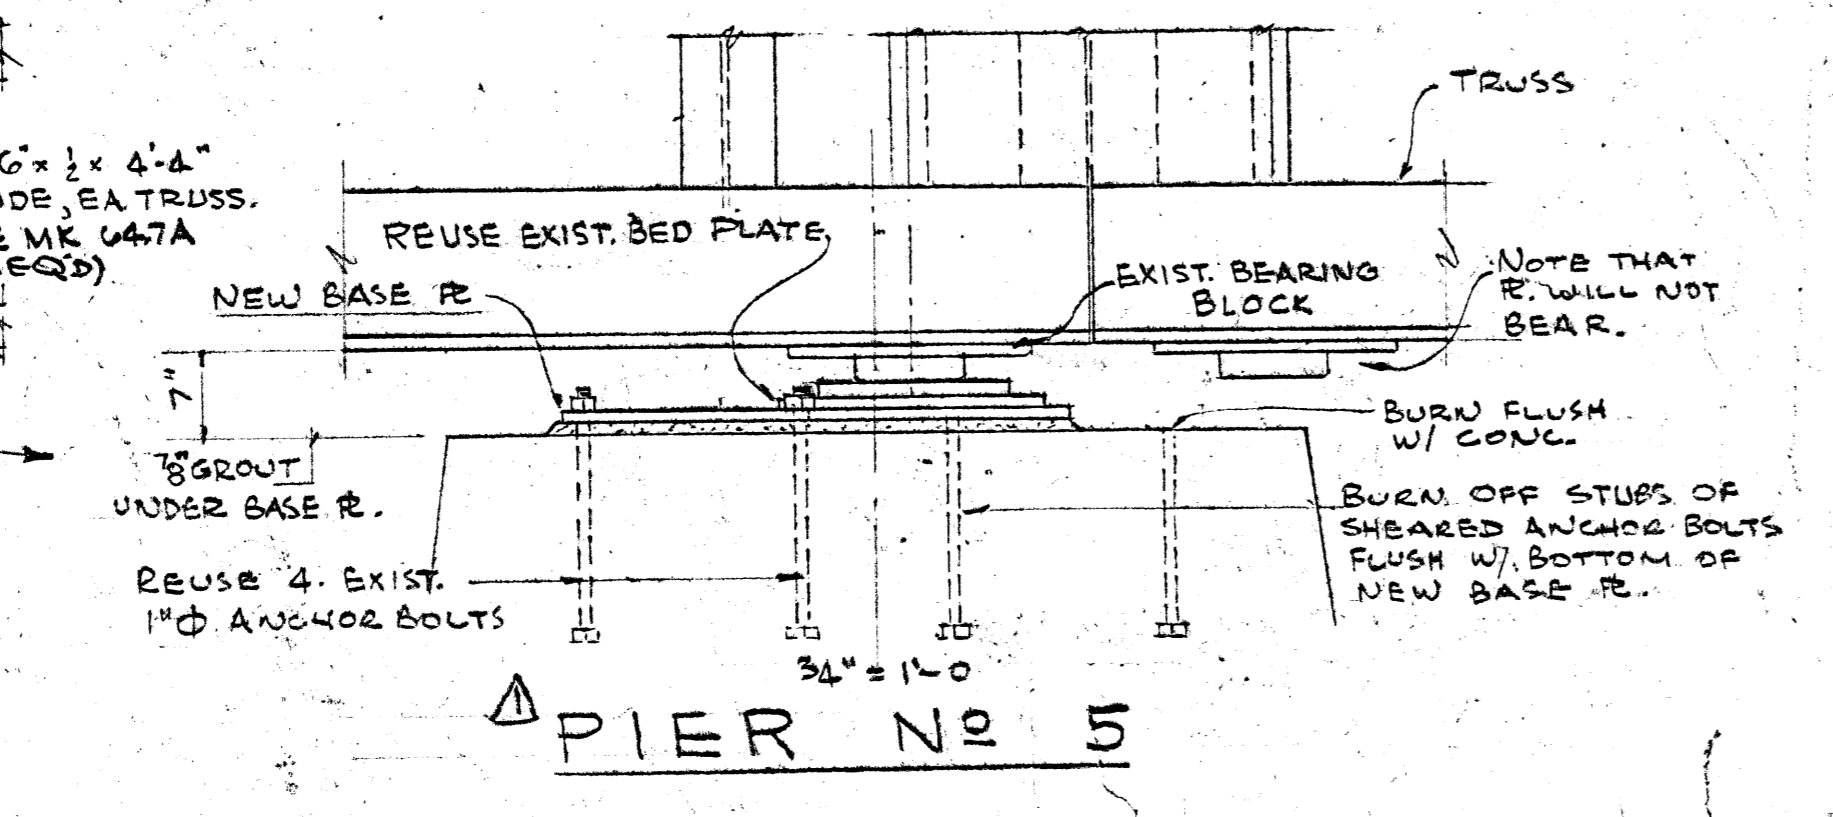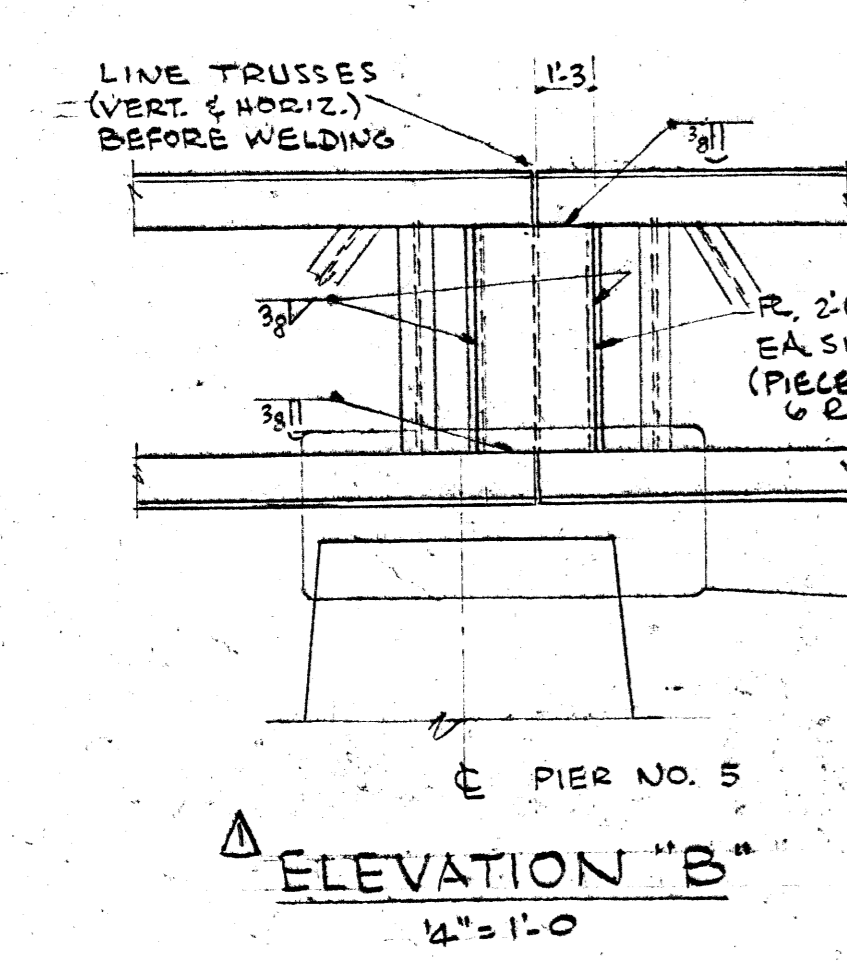

ELEVATIONS ARE TO USC & G.S. BASE

UNITED STATES
DEPARTMENT OF THE INTERIOR
THE ALASKA RAILROAD
OFFICE OF THE CHIEF ENGINEER, ANCHORAGE


BRIDGE NO. 647
TWENTY MILE RIVER

DESIGNED BY: HOLMEN RECOMMENDED: DATE: OCT, 1950
ASSISTANT CHIEF ENGR. APPROVED: RASHKIND CHIEF ENGINEER FILE NO. 6*7


REVISION NO. 1 April 2, 1964 PIER NOS & END ABUTMENTS.

SHEET 1 OF 4


All Open Holes in Top Chord Filled with Drift Pins For 15'-0" each side of $\frac{1}{2}$ of Truss.

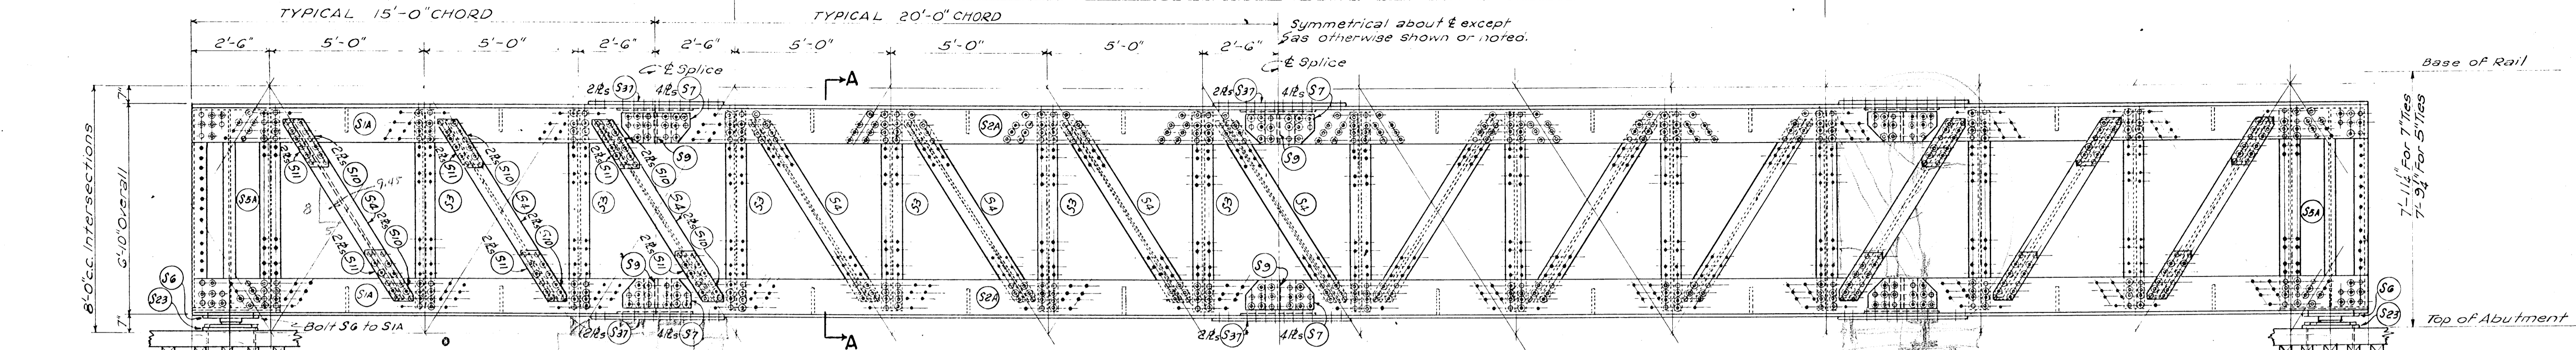


TYPICAL GENERAL ELEVATION

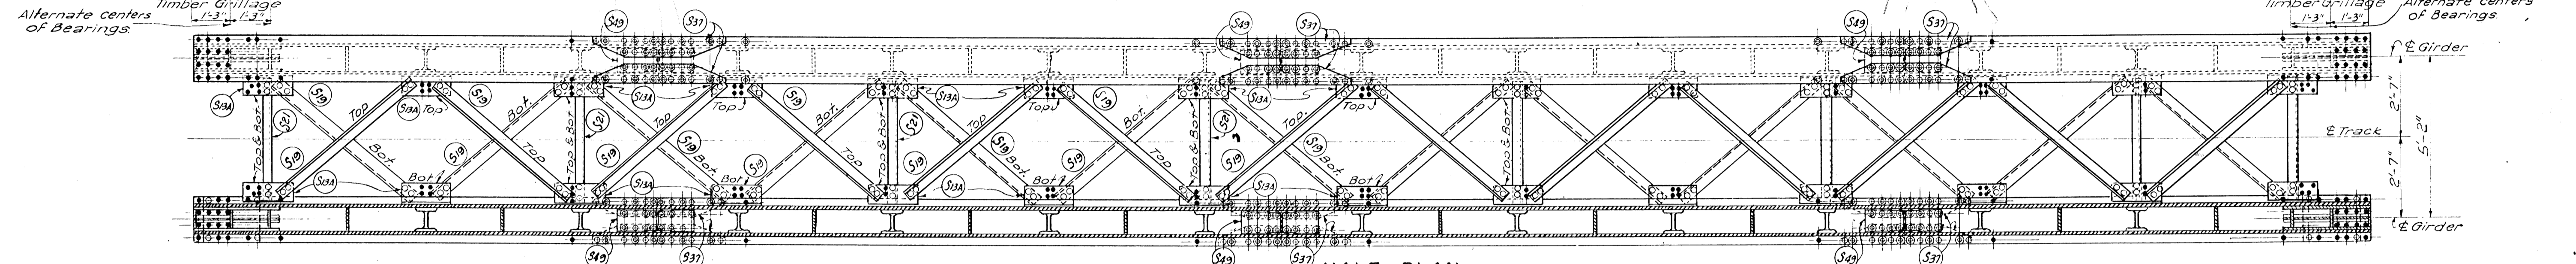


TWO GIRDER— HALF PLAN
HALF SECTIONAL PLAN

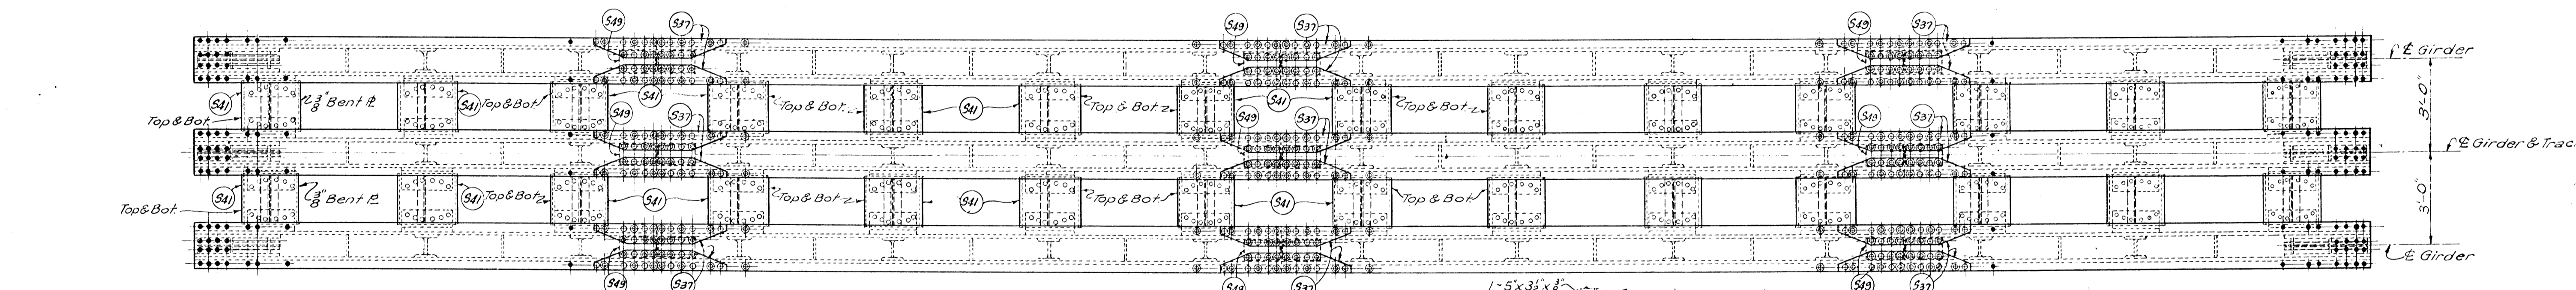


THREE GIRDER PLAN

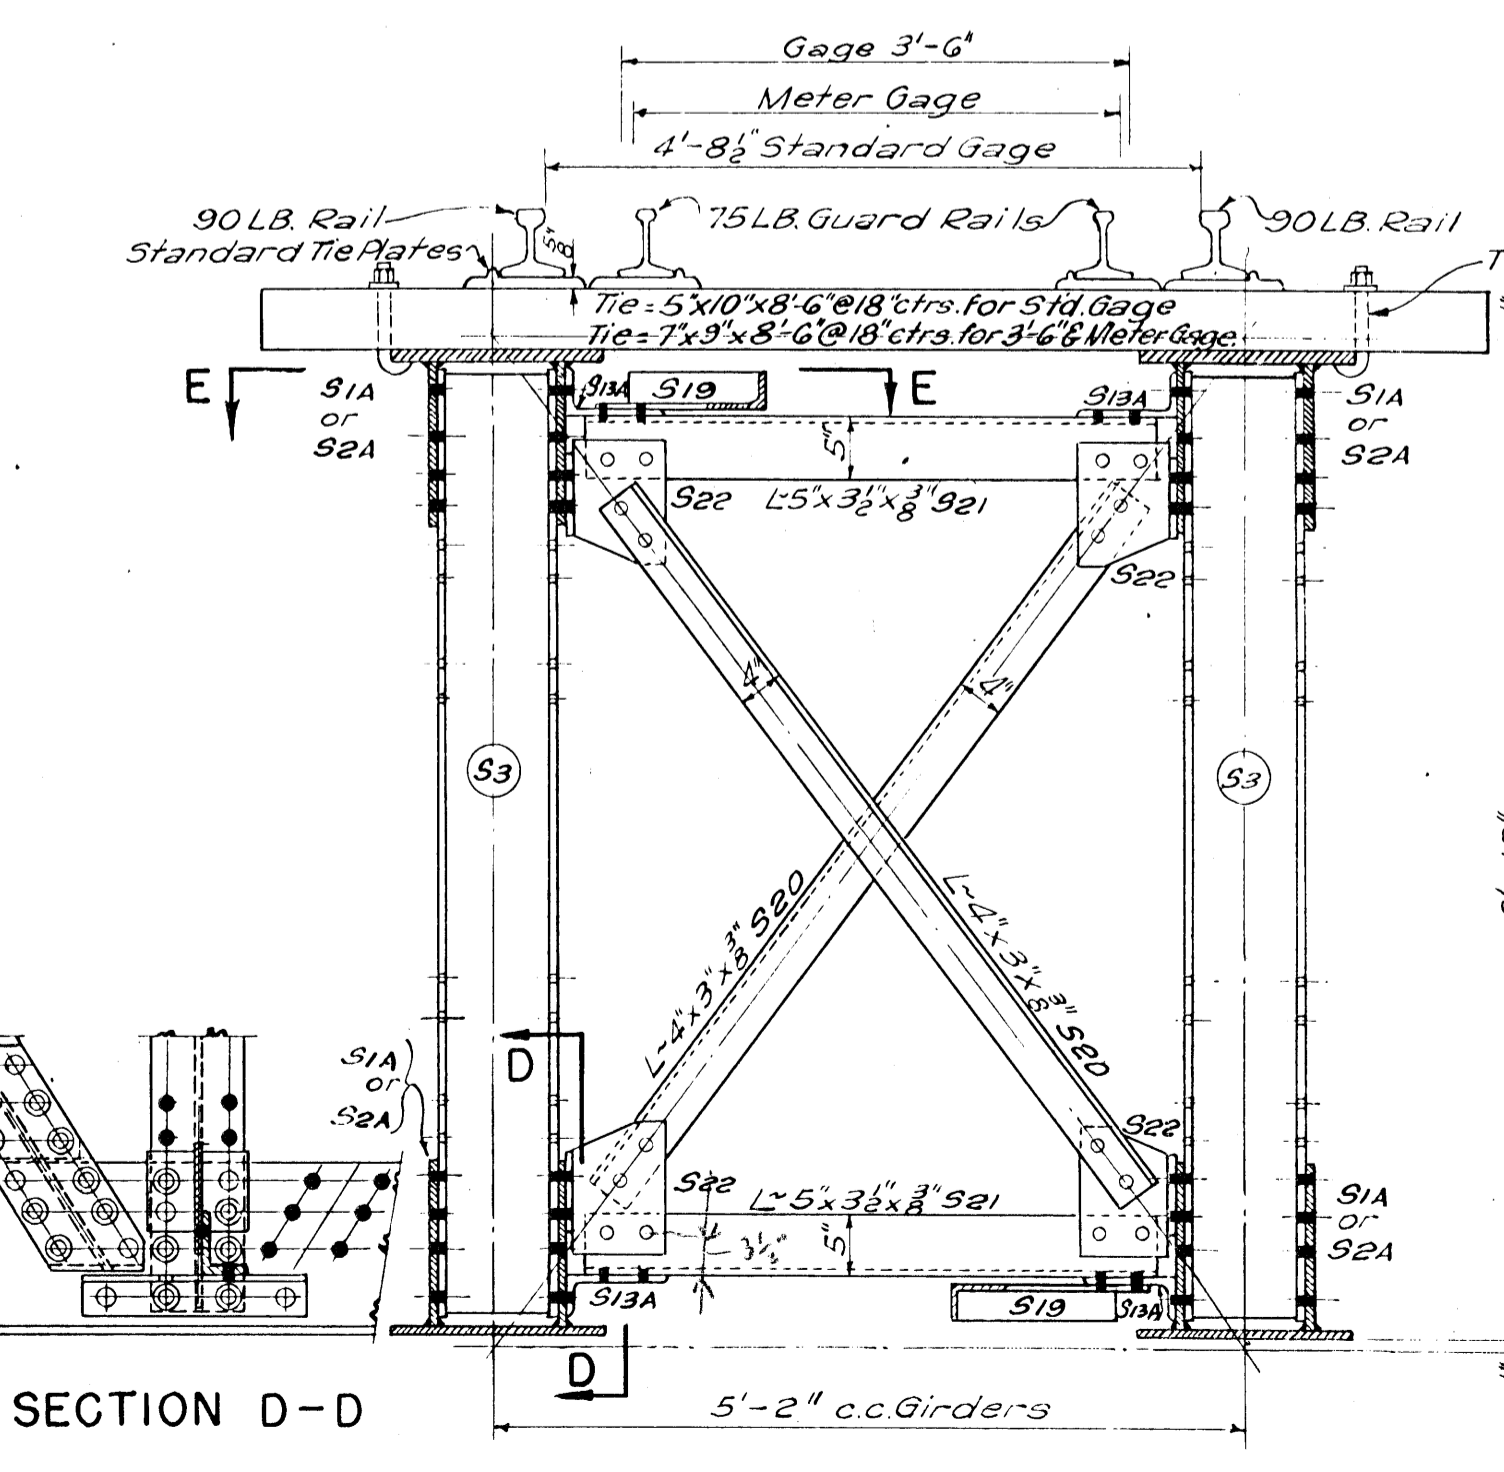


SECTION D-D
TWO GIRDER TYPICAL CROSS SECTION A-A

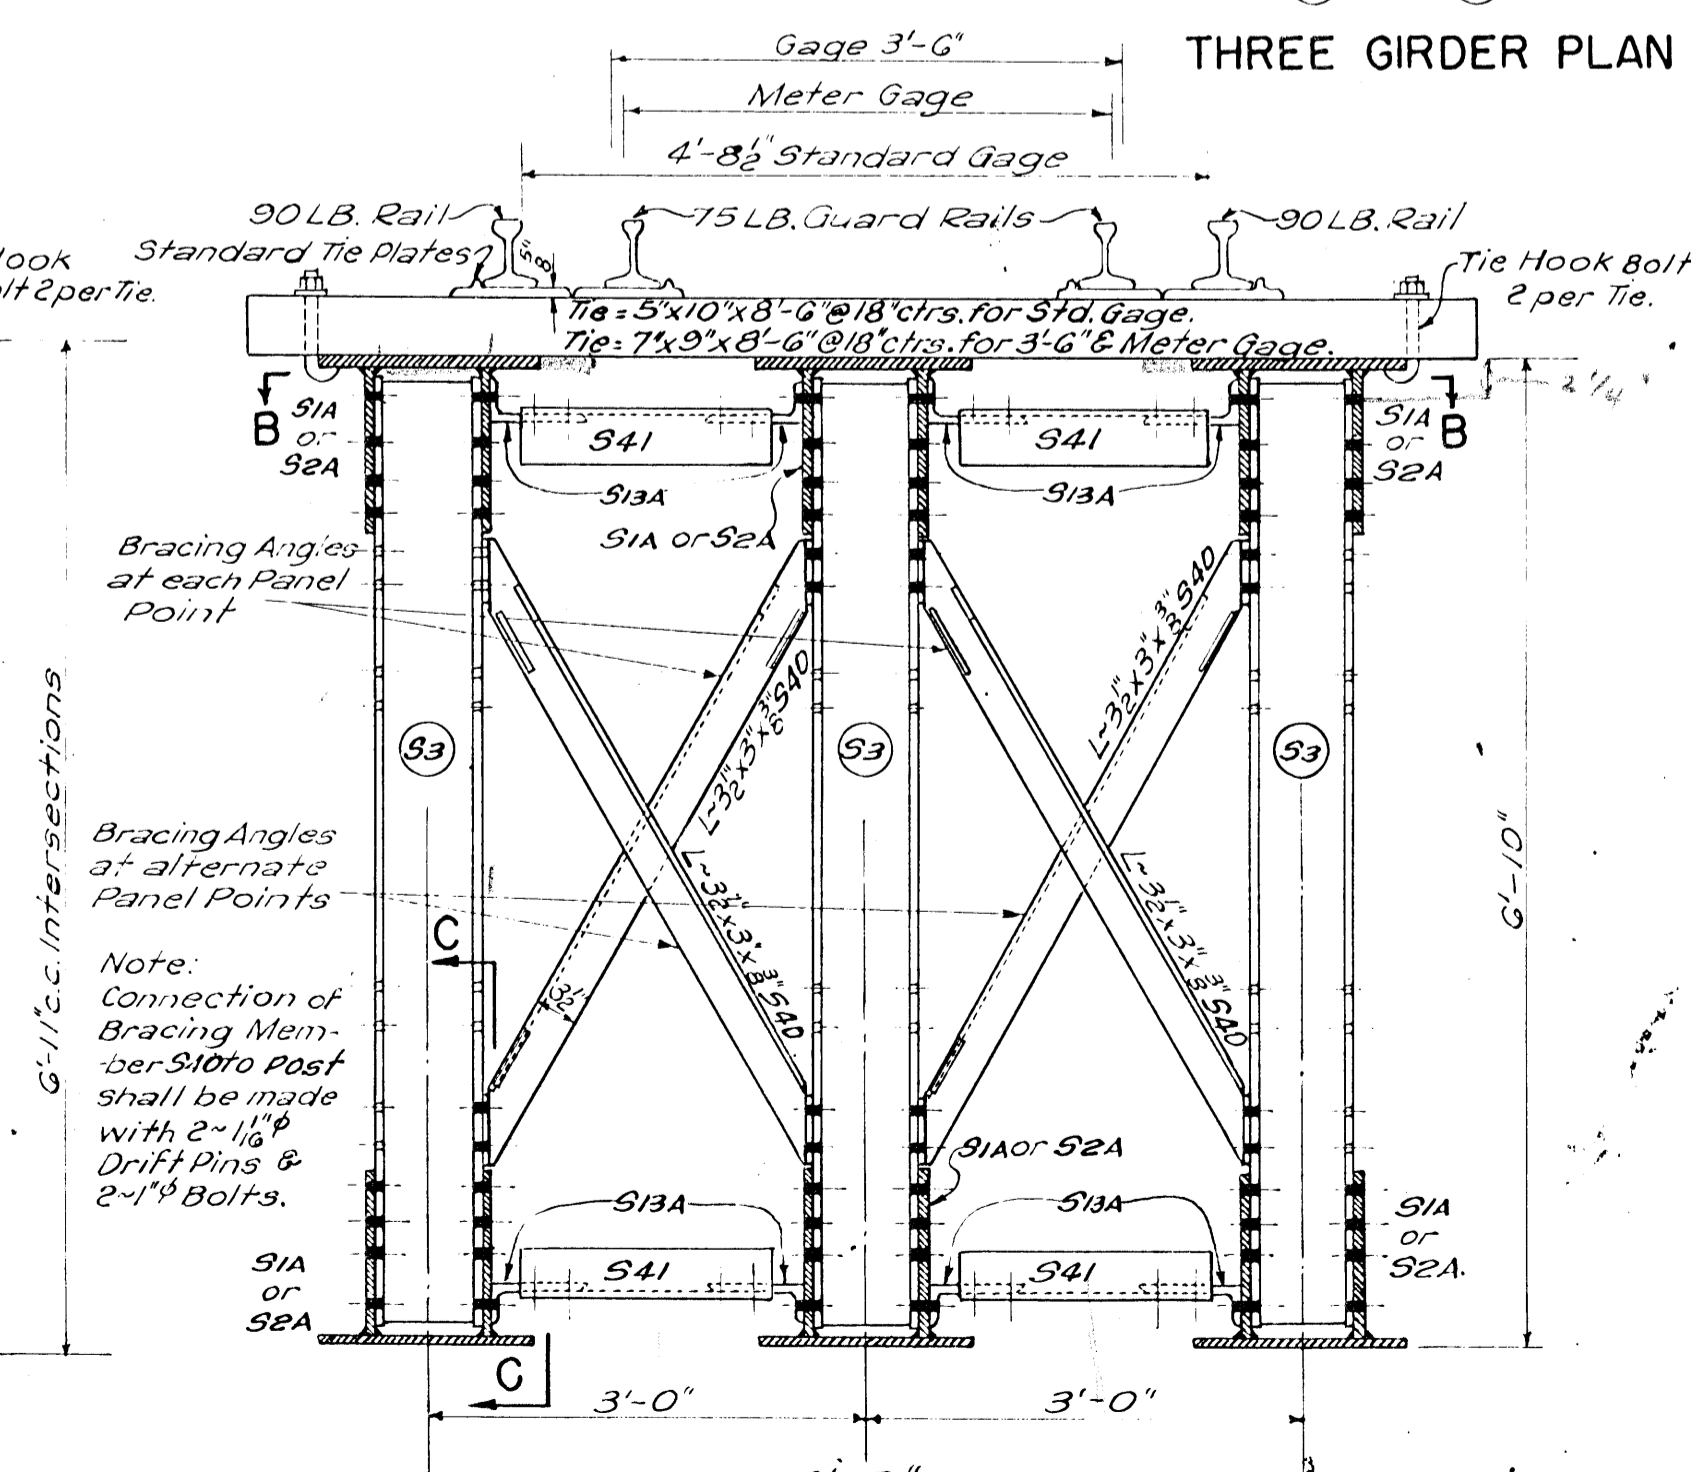

SECTION A-A
THREE GIRDER TYPICAL CROSS SECTION A-A

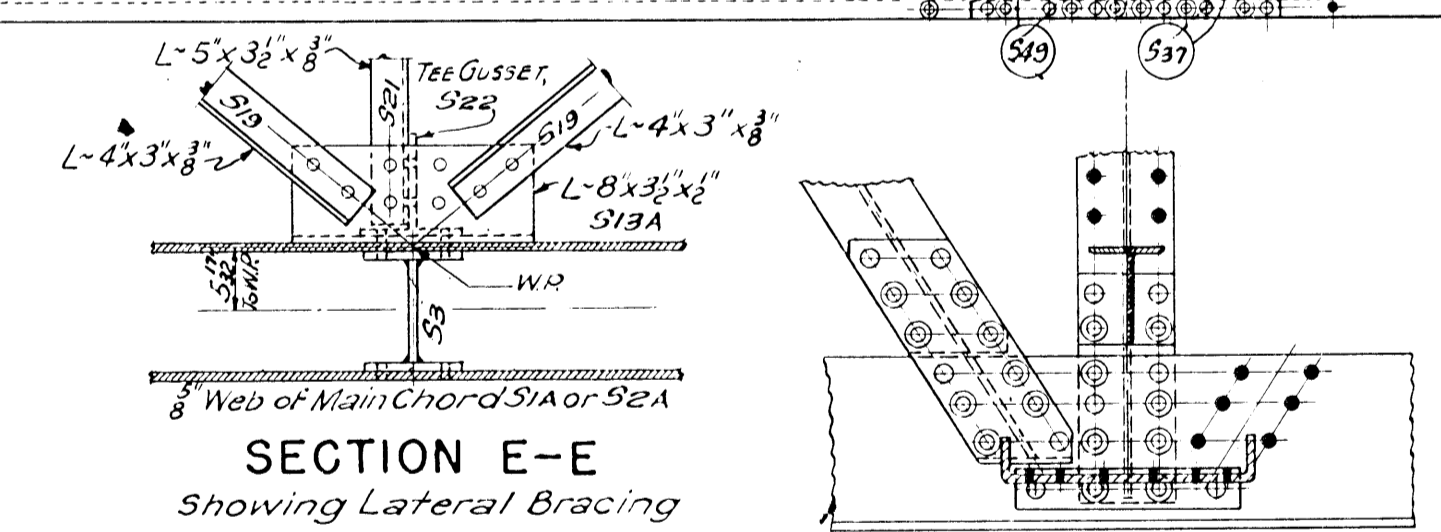

SECTION E-E
Showing Lateral Bracing

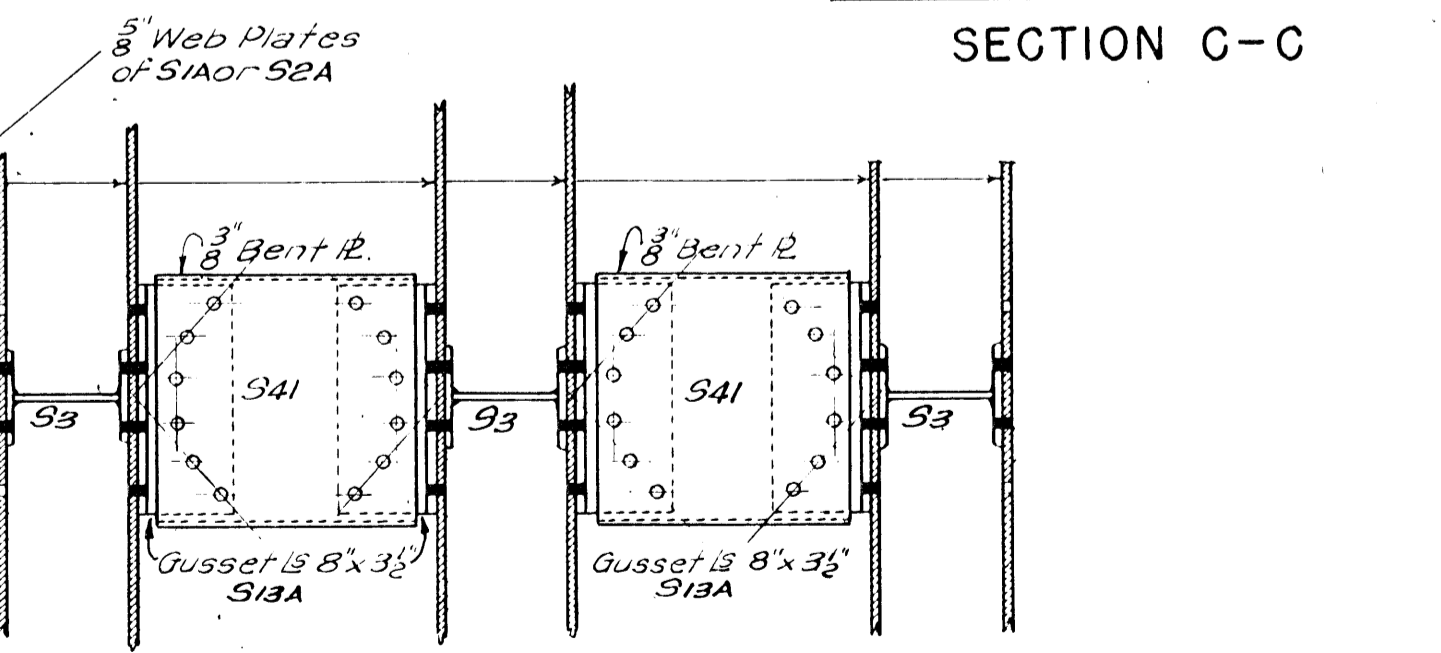


SECTION C-C
Showing Chord Bracer

NOTES:
All holes shall be 1/8" except as otherwise noted.
+ - Indicates Open Holes.
o - Indicates 1" ϕ Bolts (Field).
* - Indicates 1 1/8" ϕ Drift Pins (Field).
All bracing shall be connected by Bolts except where Drift Pins are indicated in the General Elevation of the Truss and as noted for S40, S22, & S13A.

DESIGNED		NAME		DATE	
DESIGNED		NAME		DATE	
DRAWN	F.J.T.			OCT. 1942	
TRACED	D.J.J.B.J.C.			OCT. 1942	
CHECKED	J.G.B.S.B.			DEC. 1942	
PLAN NO. D-2604-2 SHEET 2 OF 5					


WAR DEPARTMENT THE ENGINEER BOARD TECHNICAL DIVISION III BRIDGE BRANCH, STRUCTURAL DESIGN SECTION FORT BELVOIR, VIRGINIA	
UNIT CONSTRUCTION RAILWAY BRIDGE GENERAL DETAILS FOR DECK TYPE BRIDGE	
Approved for Approval 12-17-42 Howard H. Mullins SENIOR ENGINEER	
Recommended for Approval J.G.B.S.B. MAJOR C. E. ASSISTANT EXECUTIVE OFFICER	
Approved J.G.B.S.B. COL. C. E. EXECUTIVE OFFICER	

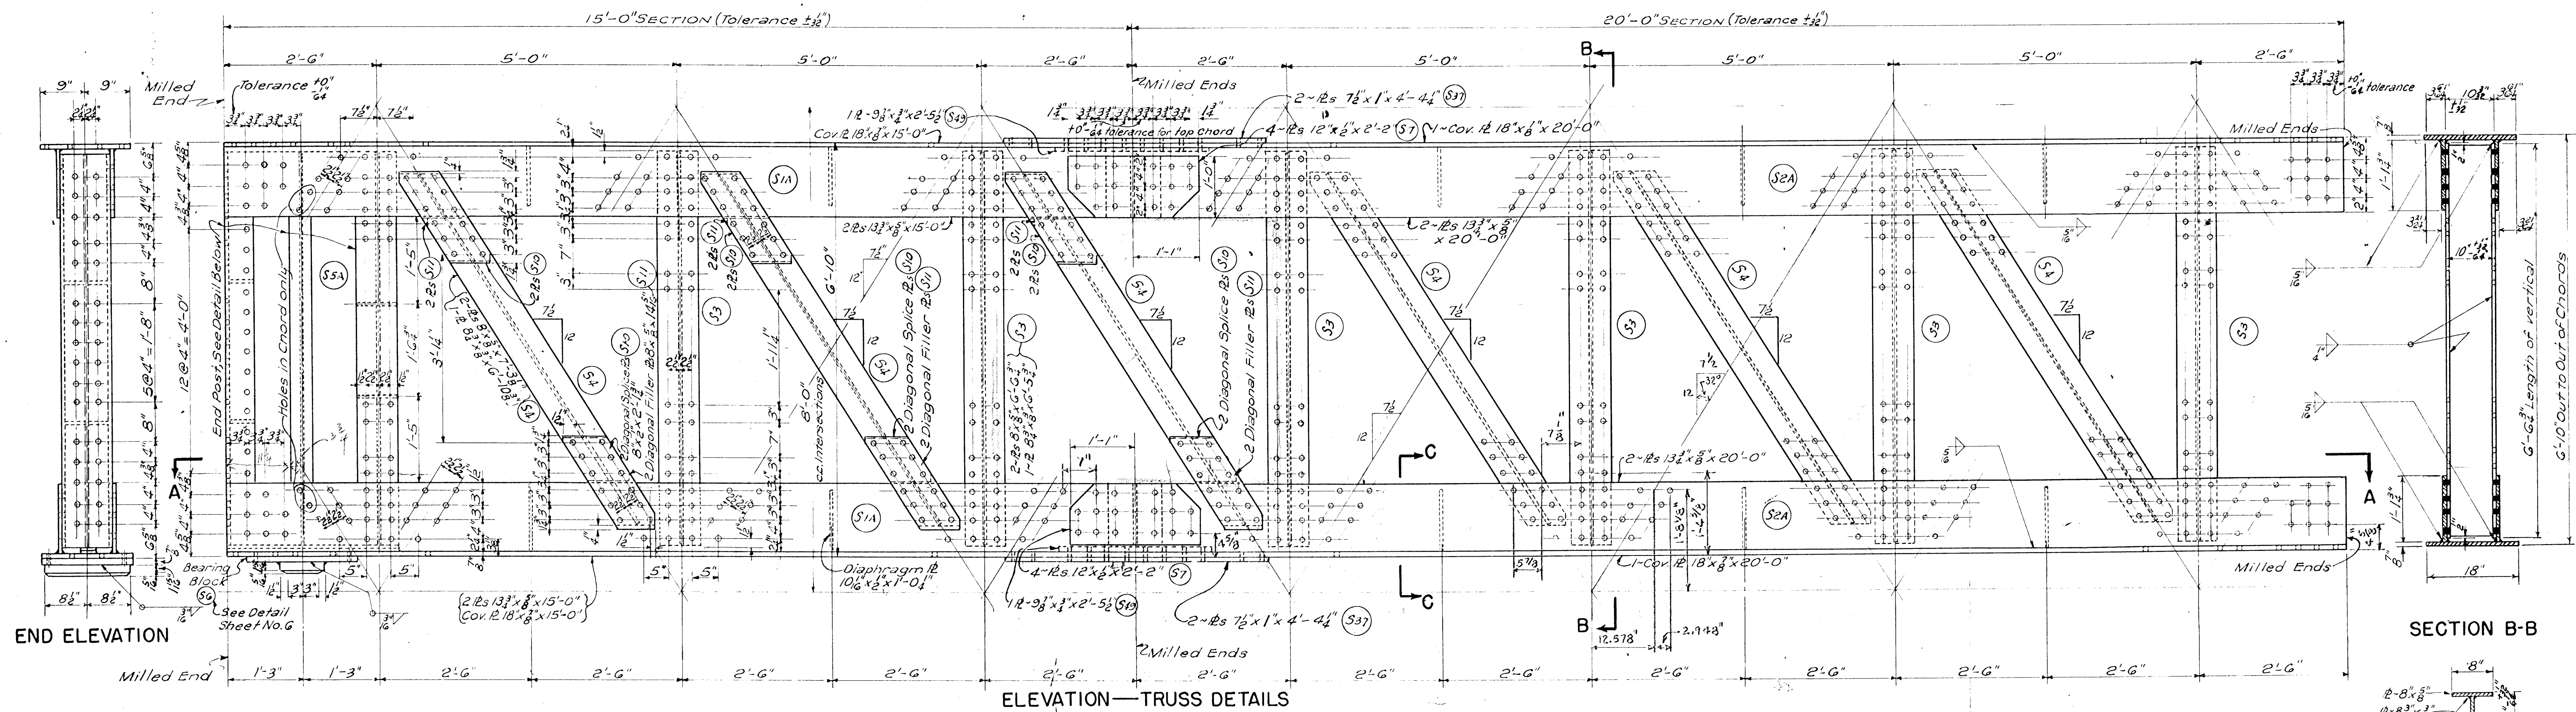

END ELEVATION


ELEVATION—TRUSS DETAILS

SECTION B-B

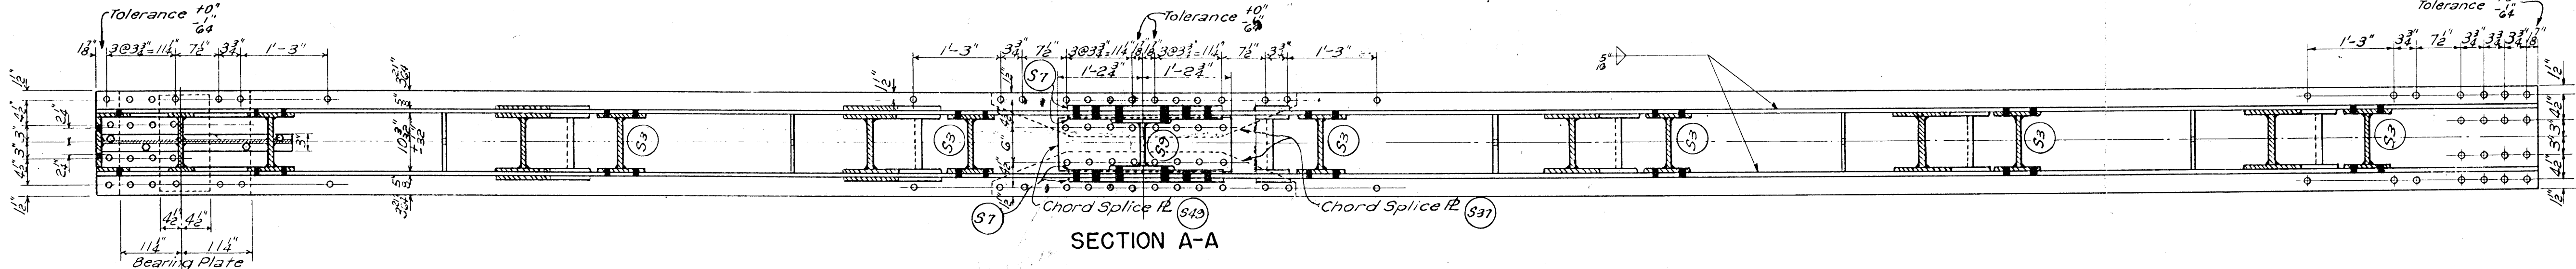


SECTION A-A


SECTION SHOWING WELDING

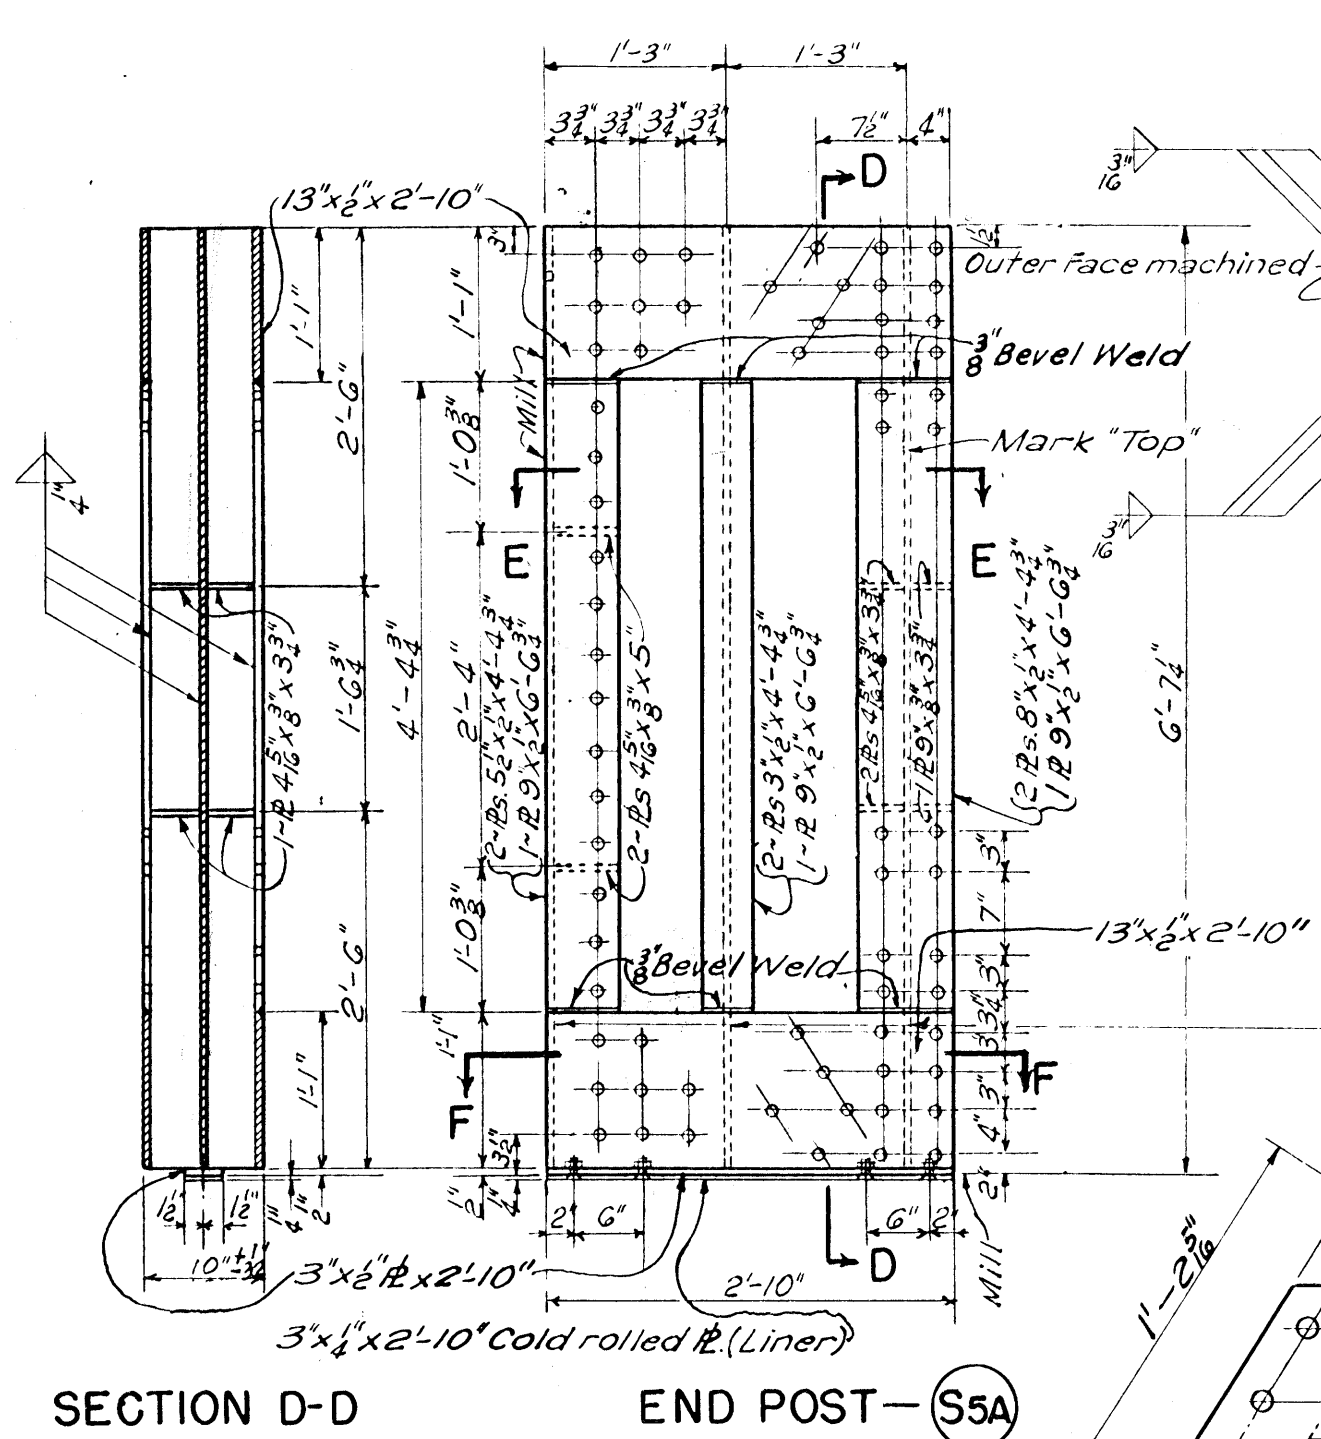


SECTION D-D END POST—S5A

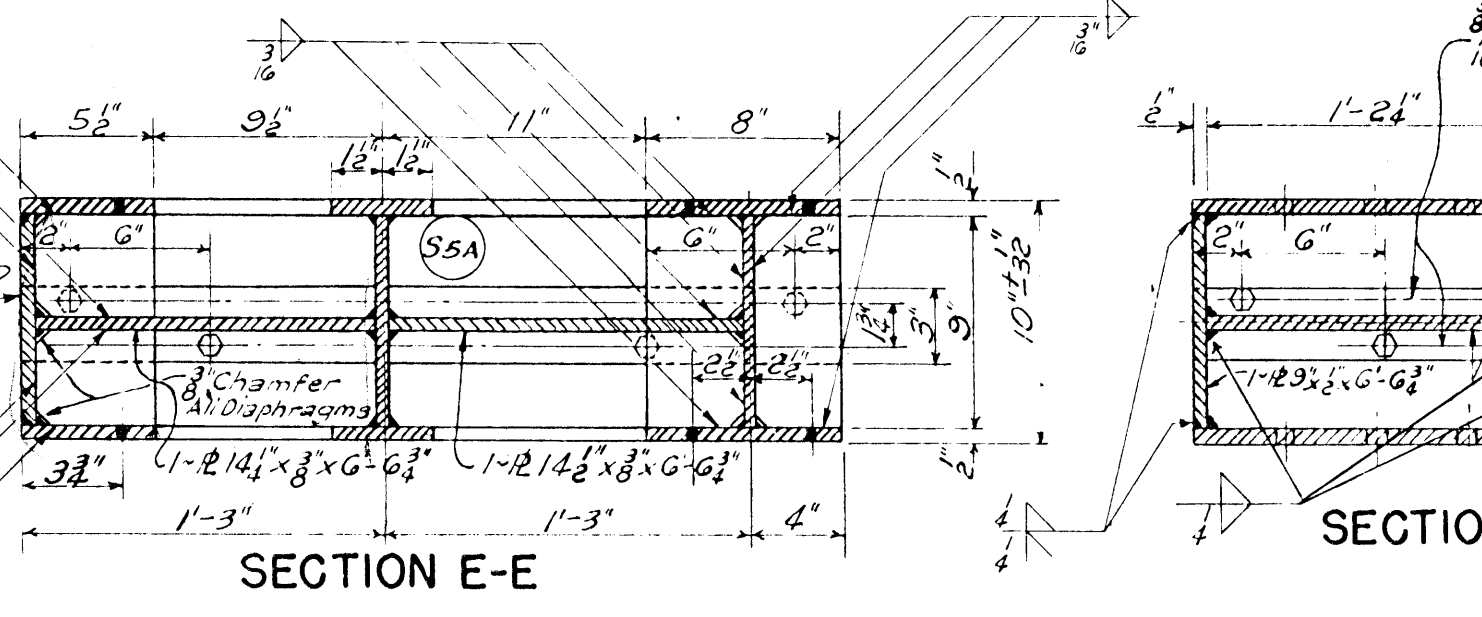


SECTION E-E

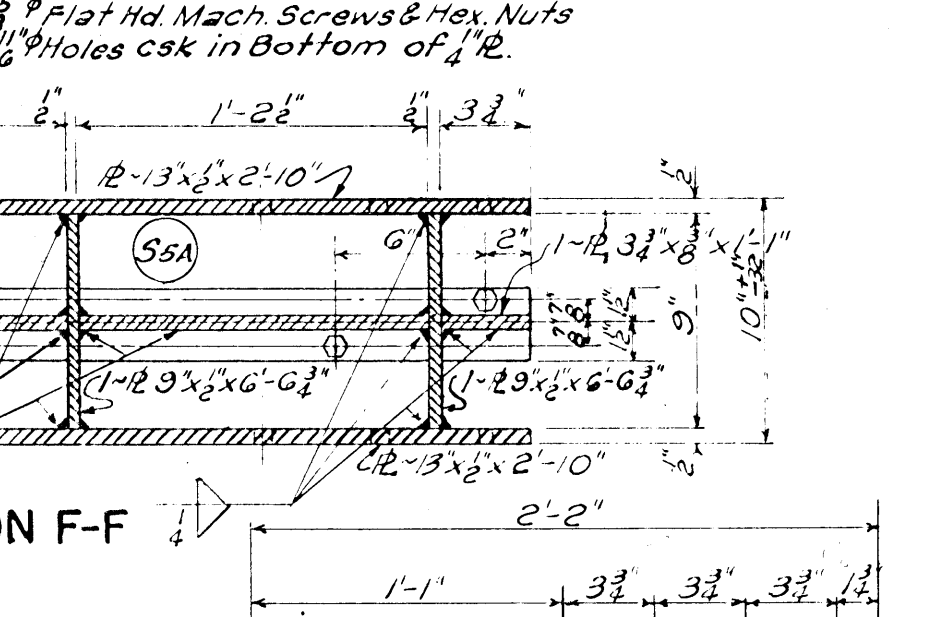


SECTION F-F

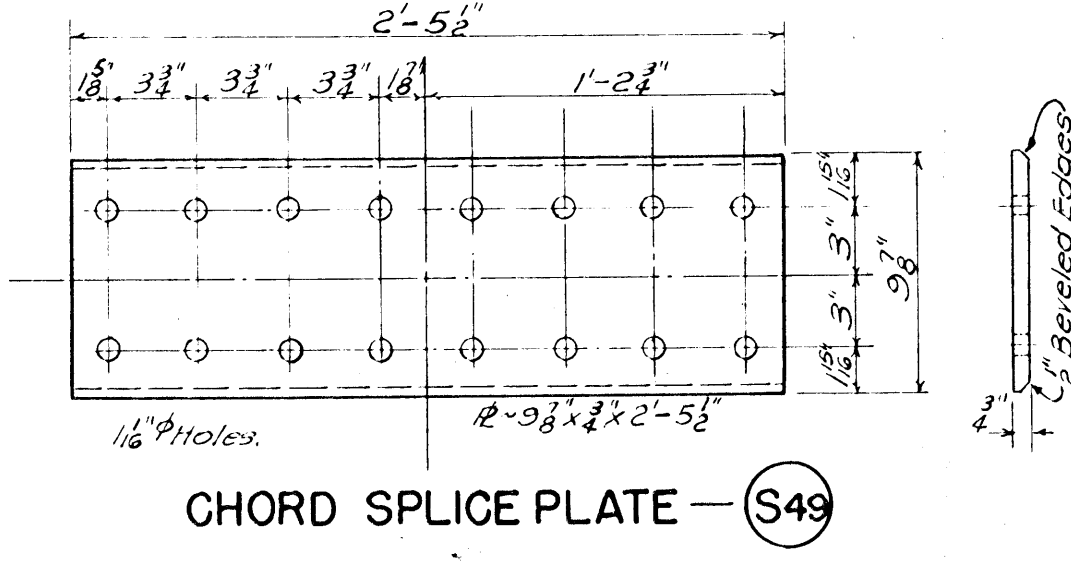


CHORD SPLICE PLATE—S49

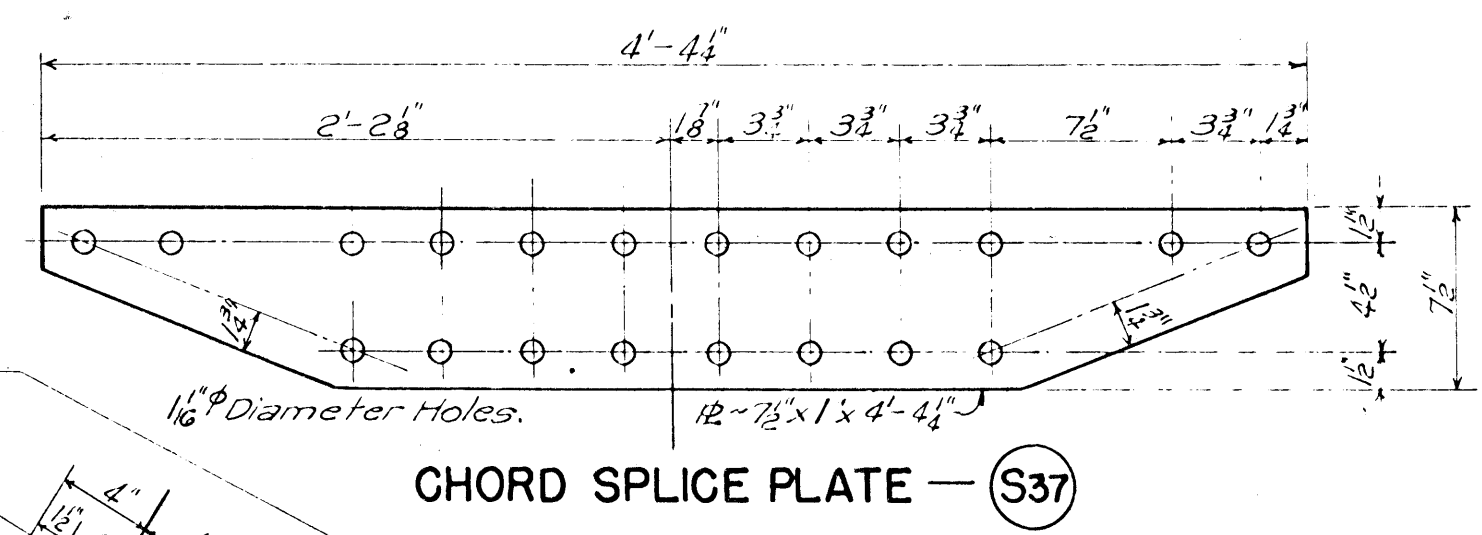


CHORD SPLICE PLATE—S37

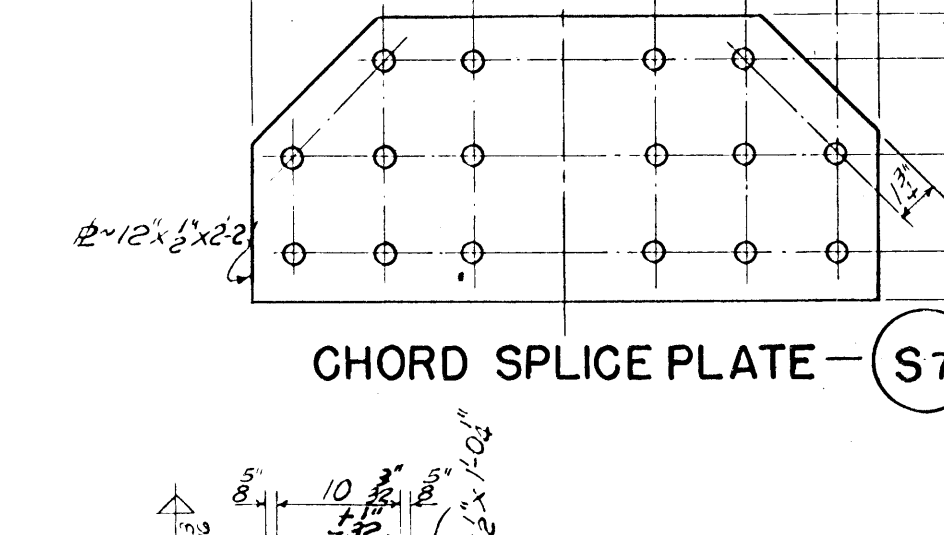

CHORD SPLICE PLATE—S7

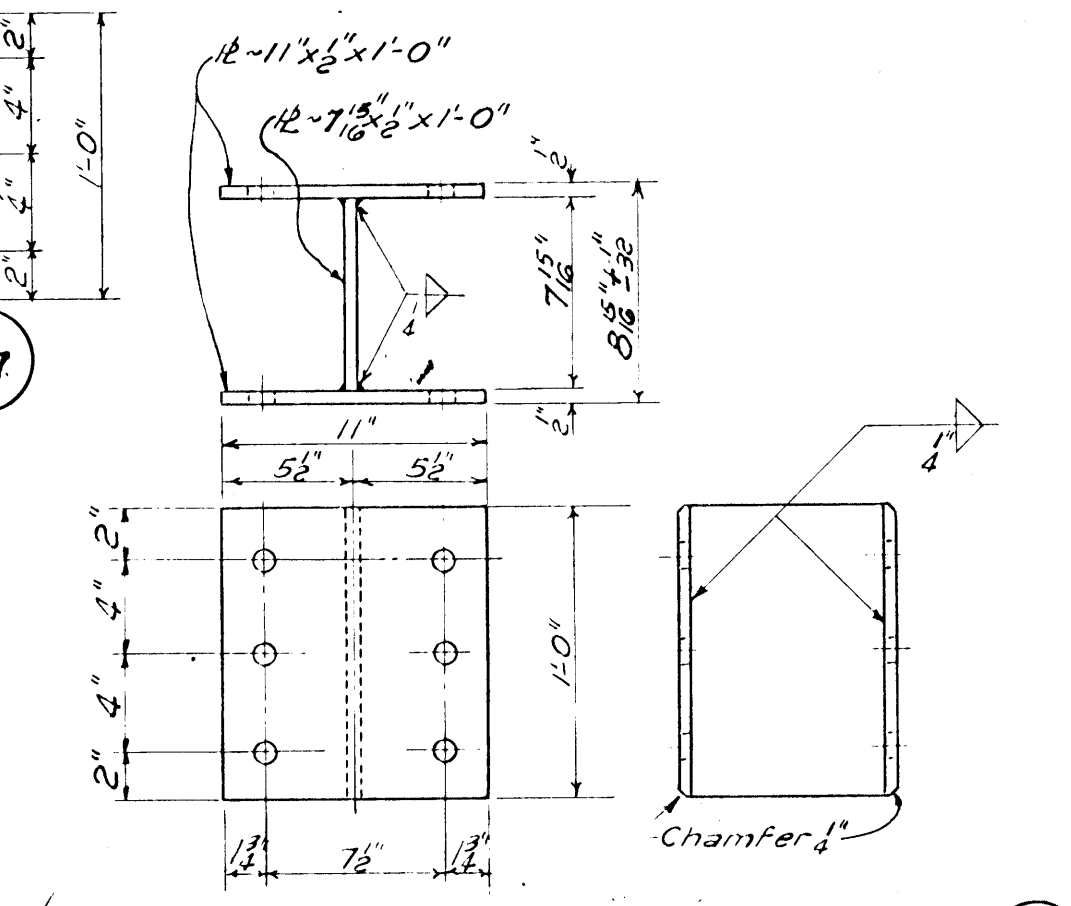

CHORD SPLICE DIAPHRAGM—S9

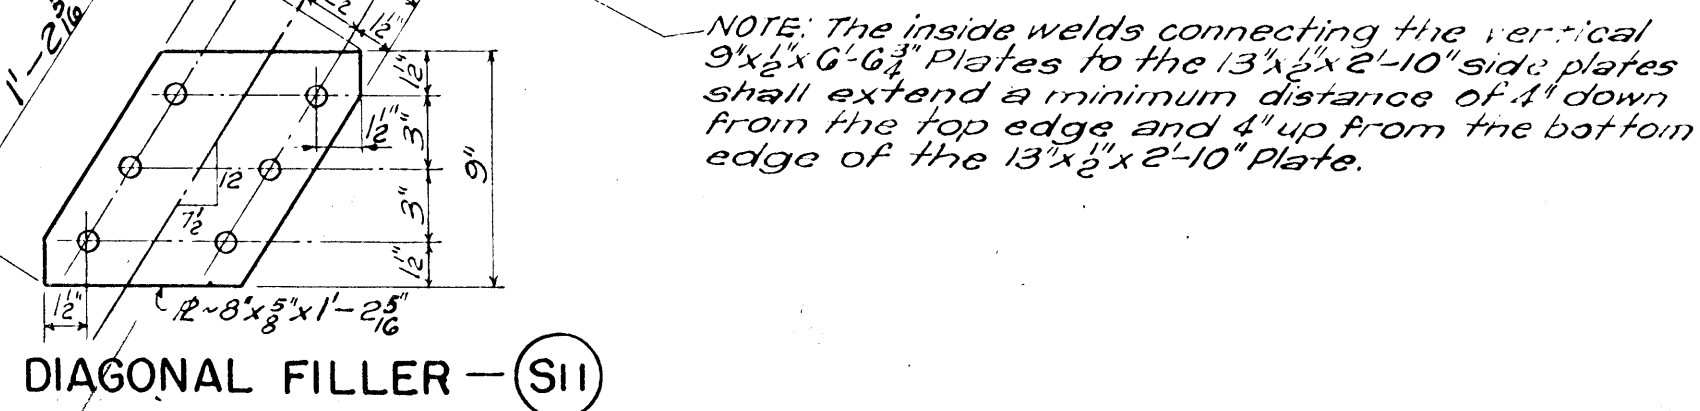


DIAGONAL FILLER—S11

NOTE: The inside welds connecting the vertical 3 x 1/2 x 2-10" Plates to the 13 x 1/2 x 2-10" side plates shall extend a minimum distance of 4" down from the top edge and 4" up from the bottom edge of the 13 x 1/2 x 2-10" Plate.



Notes:
 The ends of the chords shall be milled square and to the correct length within the tolerances shown, so as to secure a true butting surface with adjacent members.
 The end vertical face and the bottom horizontal face of the End Post shall be milled and shall be truly at right angles with one another. The end vertical face shall be milled to be flush with the ends of the top & bottom chords. The bottom face of the bottom horizontal 3 x 1/2 x 2-10" Plate shall be milled. The 3 x 1/2 x 2-10" liner may be cold rolled or hot rolled steel. If liner is hot rolled it shall be milled on top and bottom surfaces. If cold rolled it need not be milled.
 ⊕ Indicates 1/16" holes except as otherwise noted.

Note: All Fillet Welds shall be 1/4" unless otherwise noted.

WAR DEPARTMENT THE ENGINEER BOARD TECHNICAL DIVISION IX BRIDGE BRANCH, STRUCTURAL DESIGN SECTION FORT BELVOIR, VIRGINIA	
UNIT CONSTRUCTION RAILWAY BRIDGE TRUSS MEMBER DETAILS	
DESIGNED	NAME
DRAWN	F.J.T.
TRACED	D.J.J. & D.C.
CHECKED	J.G. & S.B.
PLAN NO.	D-2604-3
SHEET	3 OF 5
DATE	OCT. 1942
DATE	OCT. 1942
DATE	DEC. 1942
SUBMITTED FOR APPROVAL 12-17-42 Howard H. Mullins SENIOR ENGINEER	
RECOMMENDED FOR APPROVAL George W. Howard MAJOR C. ASSISTANT EXECUTIVE OFFICER	
APPROVED: Peter H. Goen COL. C. E. EXECUTIVE OFFICER	

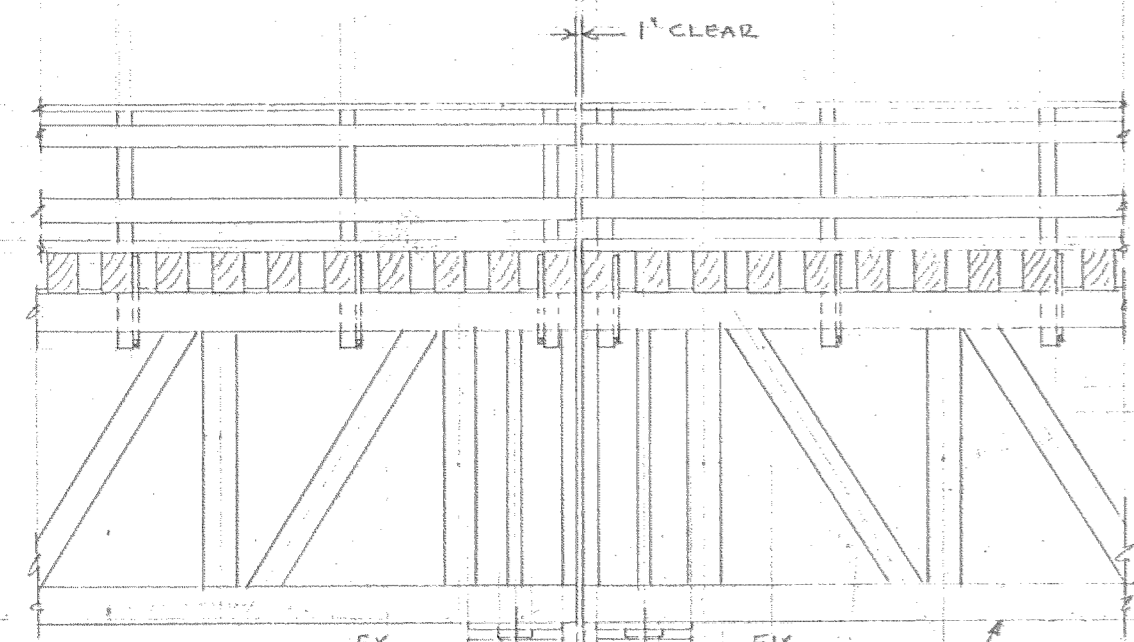

LONGITUDINAL SECTION

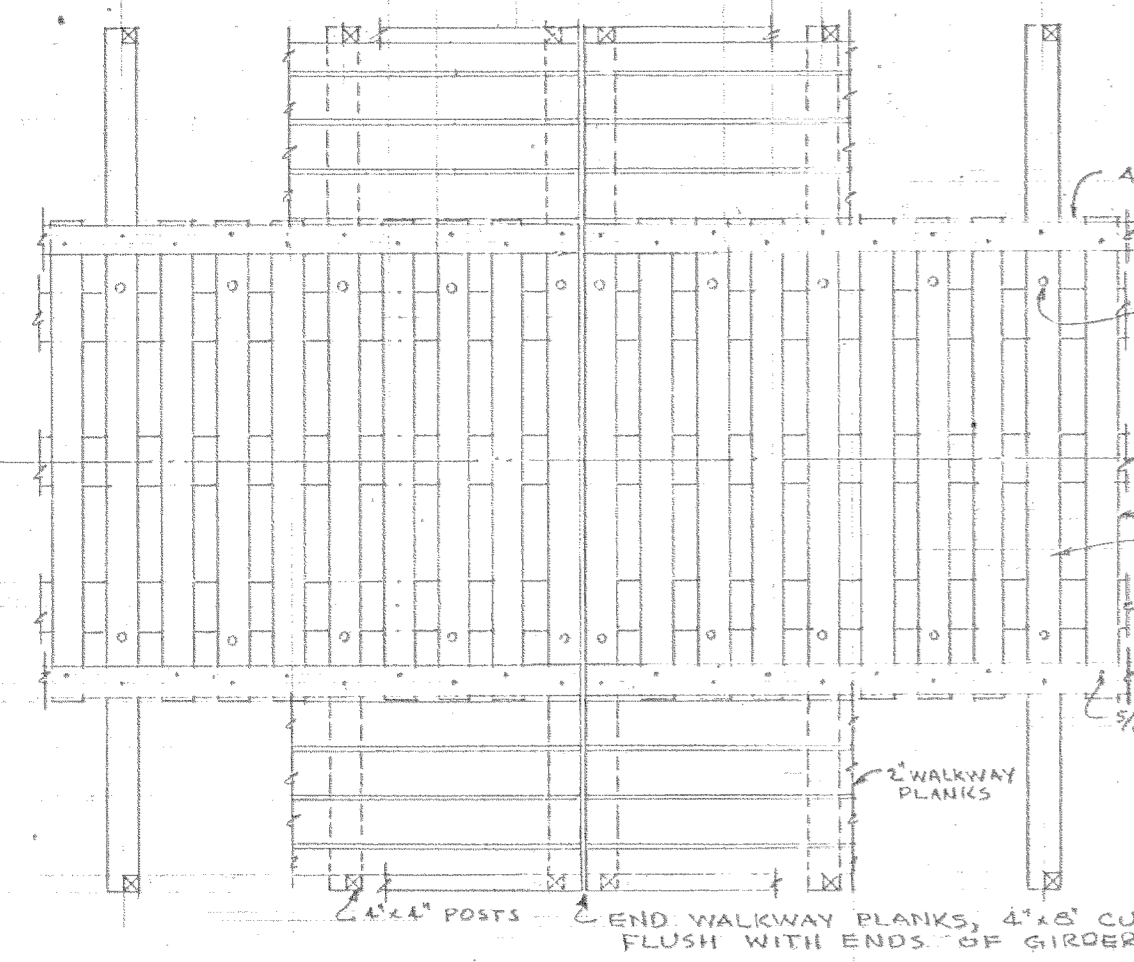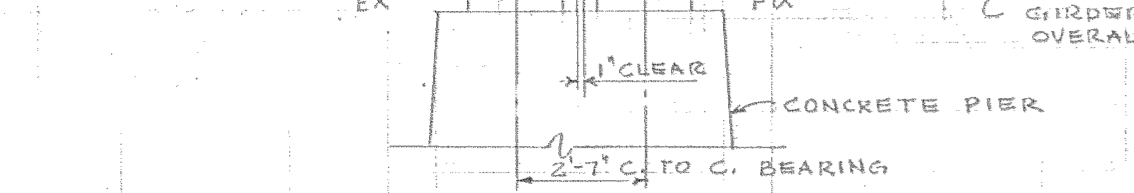

PLAN

EXPANSION DETAIL AT PIERS

SCALE: 1/4" = 1'-0"

GIRDERS SPAN OVERALL LENGTH = 70'-0"

4" x 8" CURB RAIL

HOOK BOLT AT EVERY OTHER TIE & ALL LONG TIES

NORMAL BRIDGE TIES 8" x 10" x 10'-0"
WALKWAY TIES 8" x 10" x 18'-0"

3/8" x 8" LEWIS SEALTITE LAG BOLTS

2-4" x 4" POSTS END WALKWAY PLANKS, 4" x 8" CURB RAIL & HAND RAIL FLUSH WITH ENDS OF GIRDERS AT EACH PIER

UNITED STATES
DEPARTMENT OF THE INTERIOR
THE ALASKA RAILROAD
OFFICE OF THE CHIEF ENGINEER, ANCHORAGE
EXPANSION DETAIL AT PIERS
FOR
BRIDGE 64.7


DRAWN: eaf
RECOMMENDED:
C. S. Griffith
ASSISTANT CHIEF ENGINEER
APPROVED

R. Washburn
CHIEF ENGINEER


SCALE: AS SHOWN

DATE: JULY 16, 1951

FILE NO: 64.7

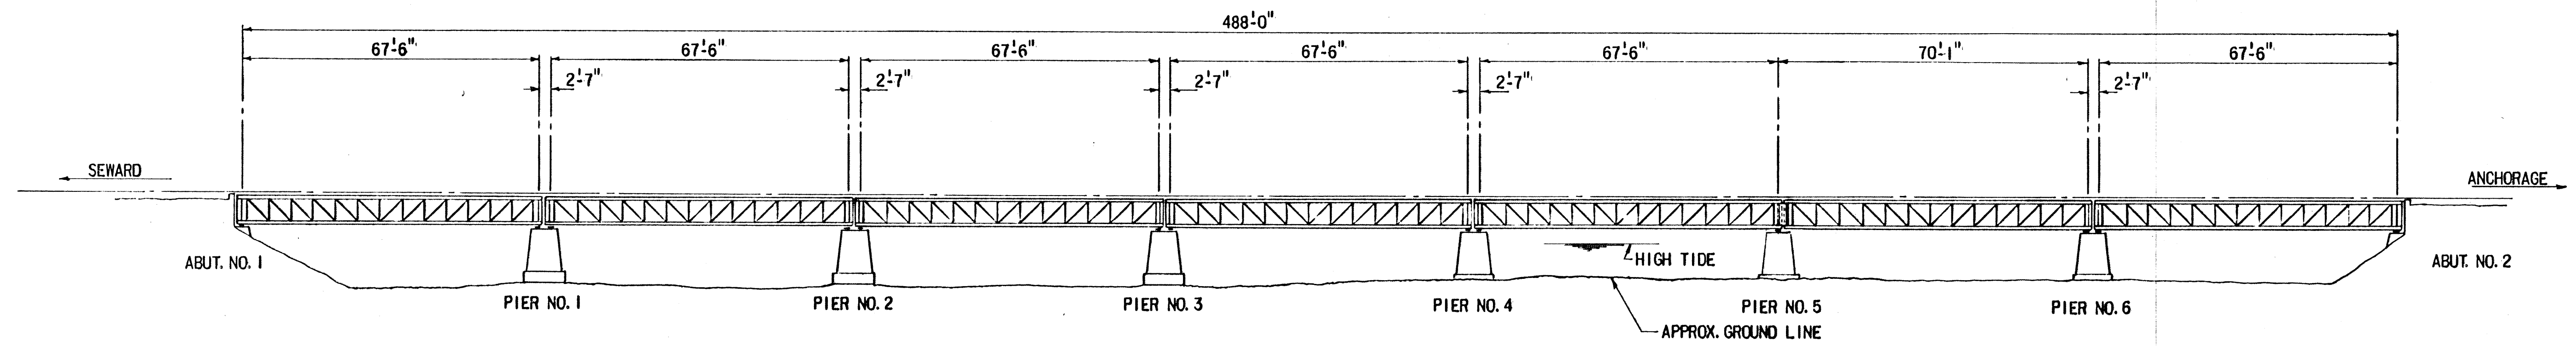

ELEVATION
SCALE: 1"=20'-0"

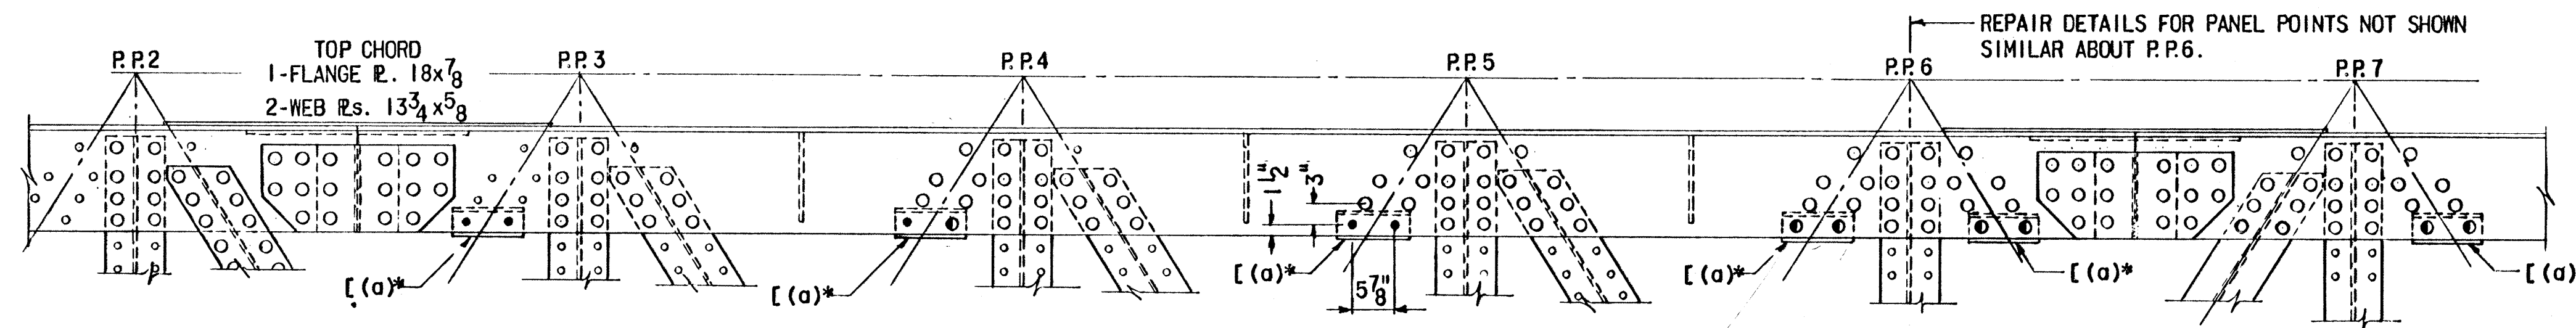

TYPICAL TOP CHORD DETAIL
(ALL GIRDERS AND SPANS)

GENERAL NOTES:

NOTES:

For complete details of girders see War Department Technical Manual TM 5-372 and revision by the Alaska Railroad, April 1964.
Existing fasteners are 1"φ rivets.

DESIGN SPECIFICATIONS

The 1967 A.R.E.A Specifications for Steel Railway Bridges shall apply.

STRUCTURAL STEEL

Material furnished under this contract shall be structural steel conforming to A.S.T.M. A36-67.

All new and replacement fasteners shall be high strength bolts conforming to A.S.T.M. A325-66b.

High strength bolts shall be 1"φ; a hardened washer shall be placed under the turned element. All permanent bolts shall be installed in accordance with "Specifications for Structural Joints using A.S.T.M. A325 or A490 Bolts" approved by the Research Council on Riveted and Bolted Structural Joints of the Engineering Foundation.

All bolt holes in the new material shall be sub-drilled 3/16" smaller than nominal size of bolt, assembled and reamed or drilled to full size to match the existing holes in the member.

PROCEDURE FOR INSTALLATION OF STRENGTHENING MATERIALS

The general requirement for placing new bolts and material shall be as follows:

1. All paint from the existing material in area of holes for new and replaced bolts and all rust and loose paint from areas to be in contact with new material shall be removed.
2. Each rivet removed, shall be immediately replaced with a properly tightened high strength bolt. Rivets shall not be removed by burning.
3. Clean and paint all new material and abraded paint surfaces with two coats of paint in the field.


LEGEND

Symbols and their definitions are as follows:

- Existing fasteners.
- Existing open holes to remain open.
- Existing holes to be filled with H.S. Bolts.
- Existing fasteners to be removed and replaced with H.S. Bolts.
- * New material, all others existing.


MATERIAL LIST

189-10"x4" [28.5 x 0'-9 1/2"
756-1"φ x 2 3/4" bolts
Furnish hex head bolts, nuts and washers (provide one hardened washer for each bolt; also, provide one hardened beveled washer for each bolt if slope of channel flange exceeds 1:20).

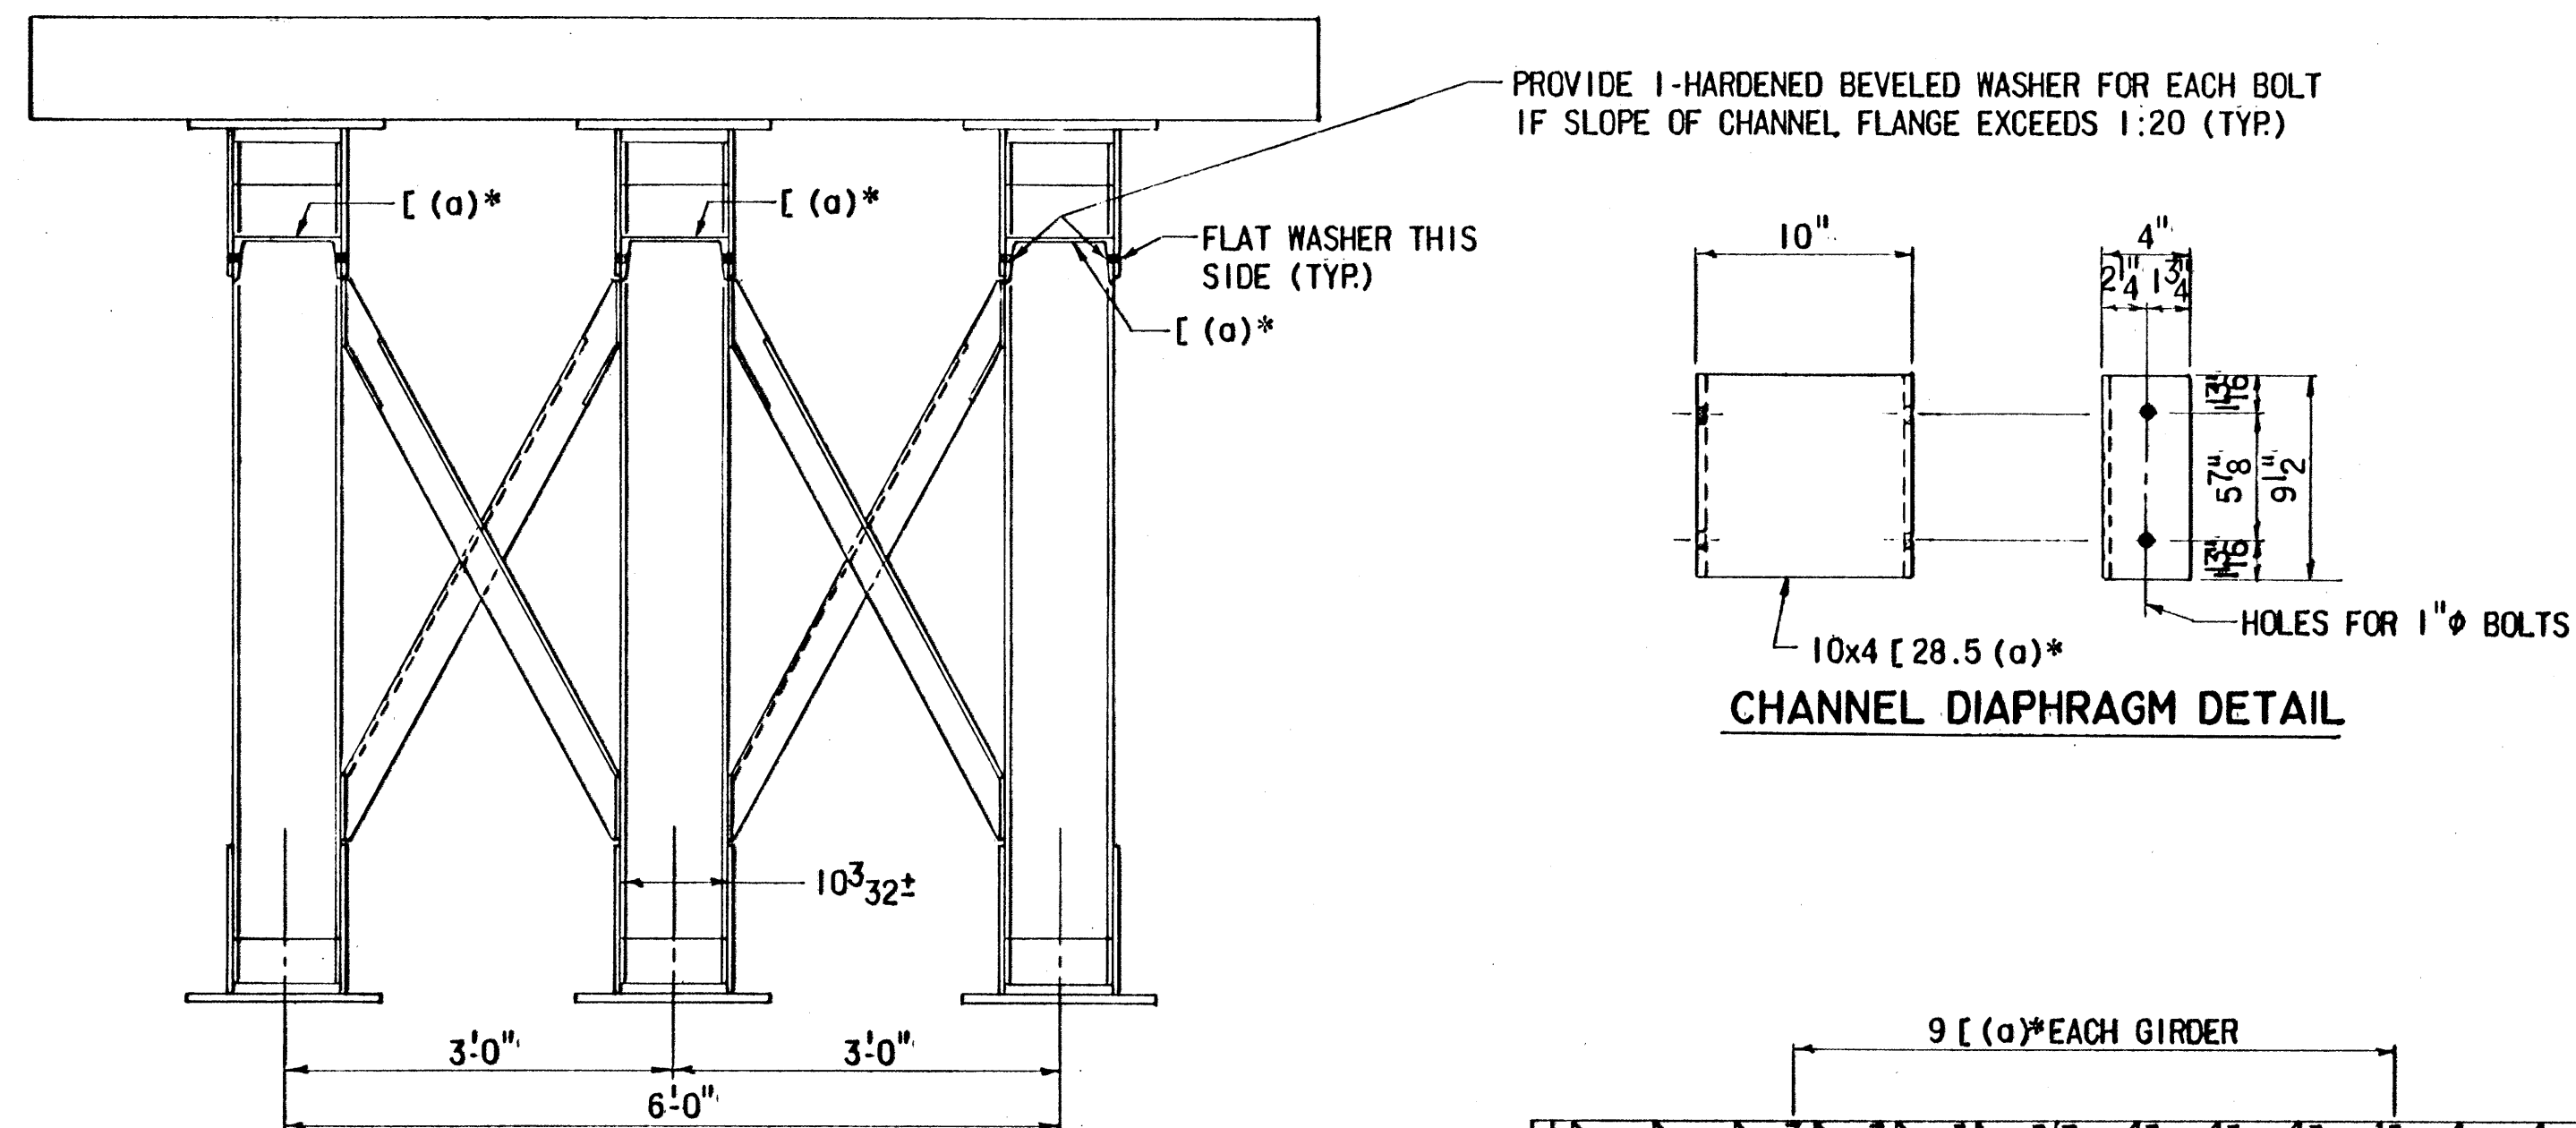


TYPICAL CROSS SECTION

CHANNEL DIAPHRAGM DETAIL

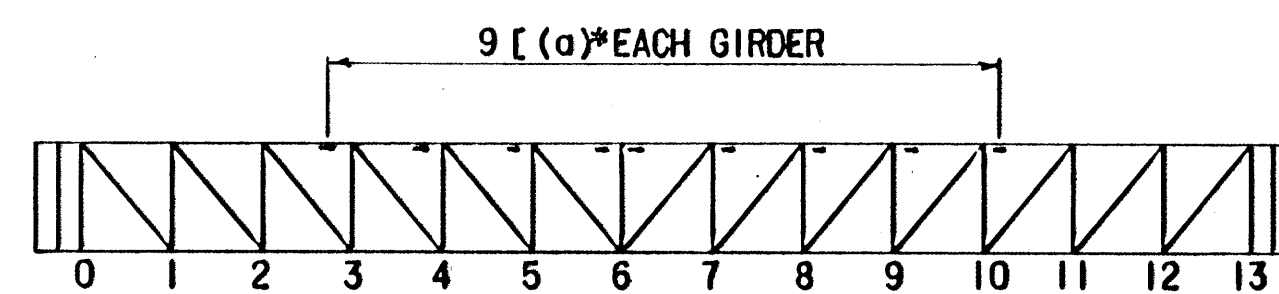

GIRDER KEY ELEVATION


0371 0105 5120 3368

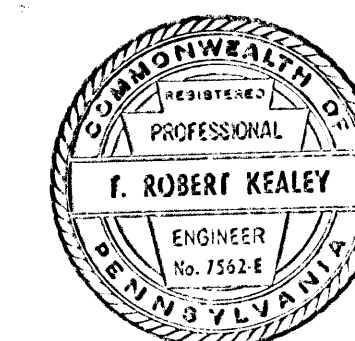


F. Robert Kealey
PREPARED BY
MODJESKI & MASTERS
HARRISBURG, PA.

REVISION	DATE	DESCRIPTION	BY
UNITED STATES DEPARTMENT OF TRANSPORTATION FEDERAL RAILROAD ADMINISTRATION THE ALASKA RAILROAD OFFICE OF THE CHIEF ENGINEER, ANCHORAGE STRENGTHENING OF THE BRIDGE NO. 64.7 GIRDER SPAN - DETAILS			
SUBMITTED:		SCALE: 3/8"=1'-0" UNLESS NOTED	
APPROVED:		DATE: DECEMBER 1968	
CHIEF ENGINEER		SHEET 1 OF 1	
		FILE NO. 64.7-A	


DR.CWH/CK.HS

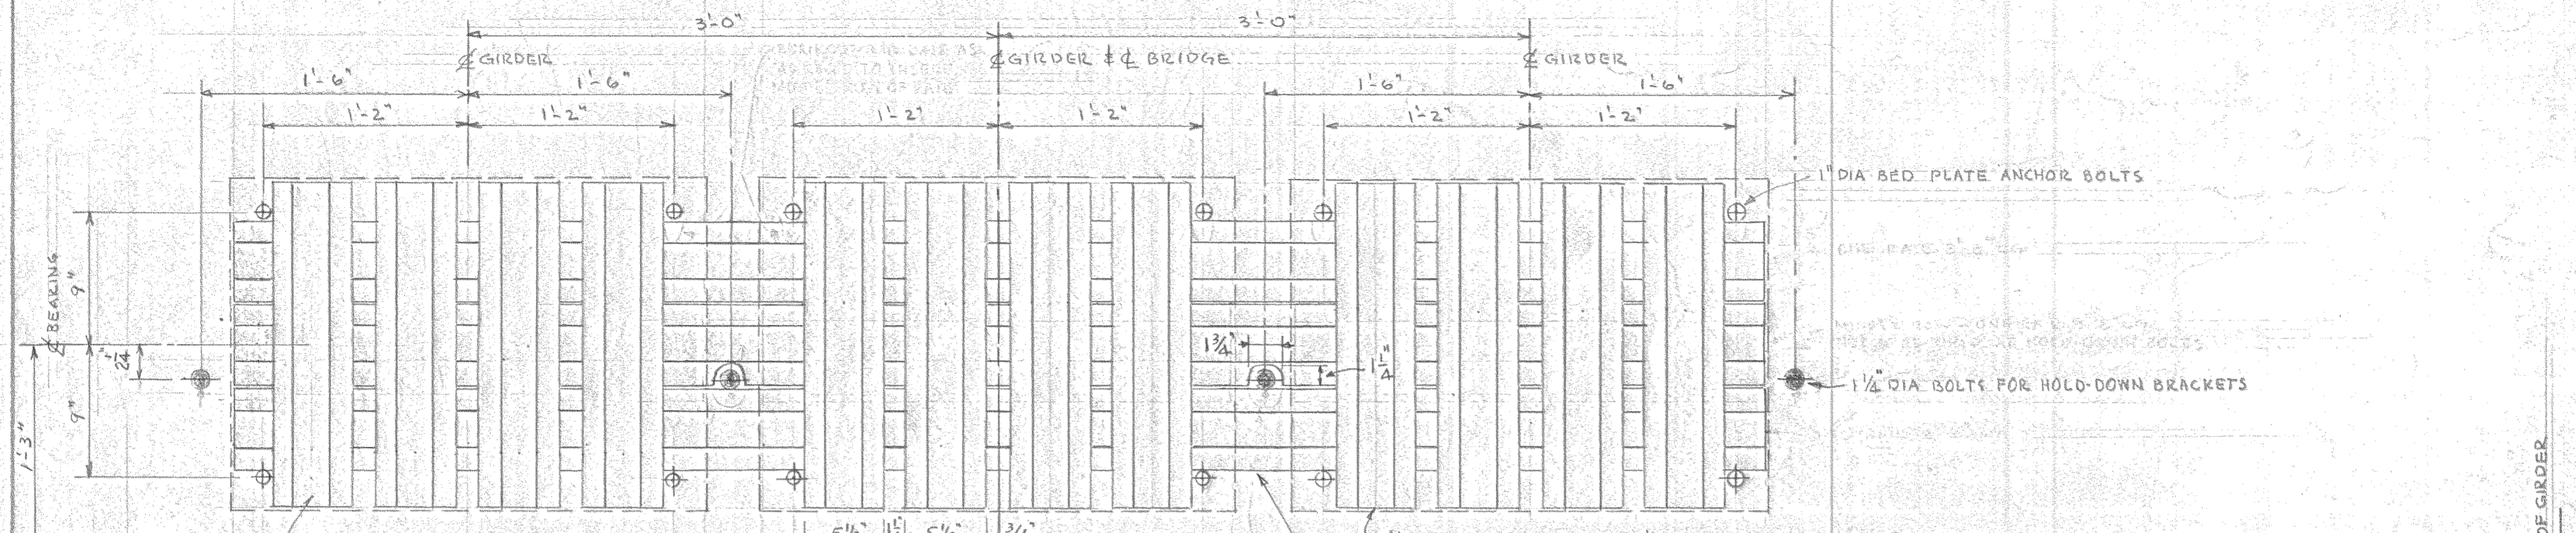

PLAN AT ABUTMENT

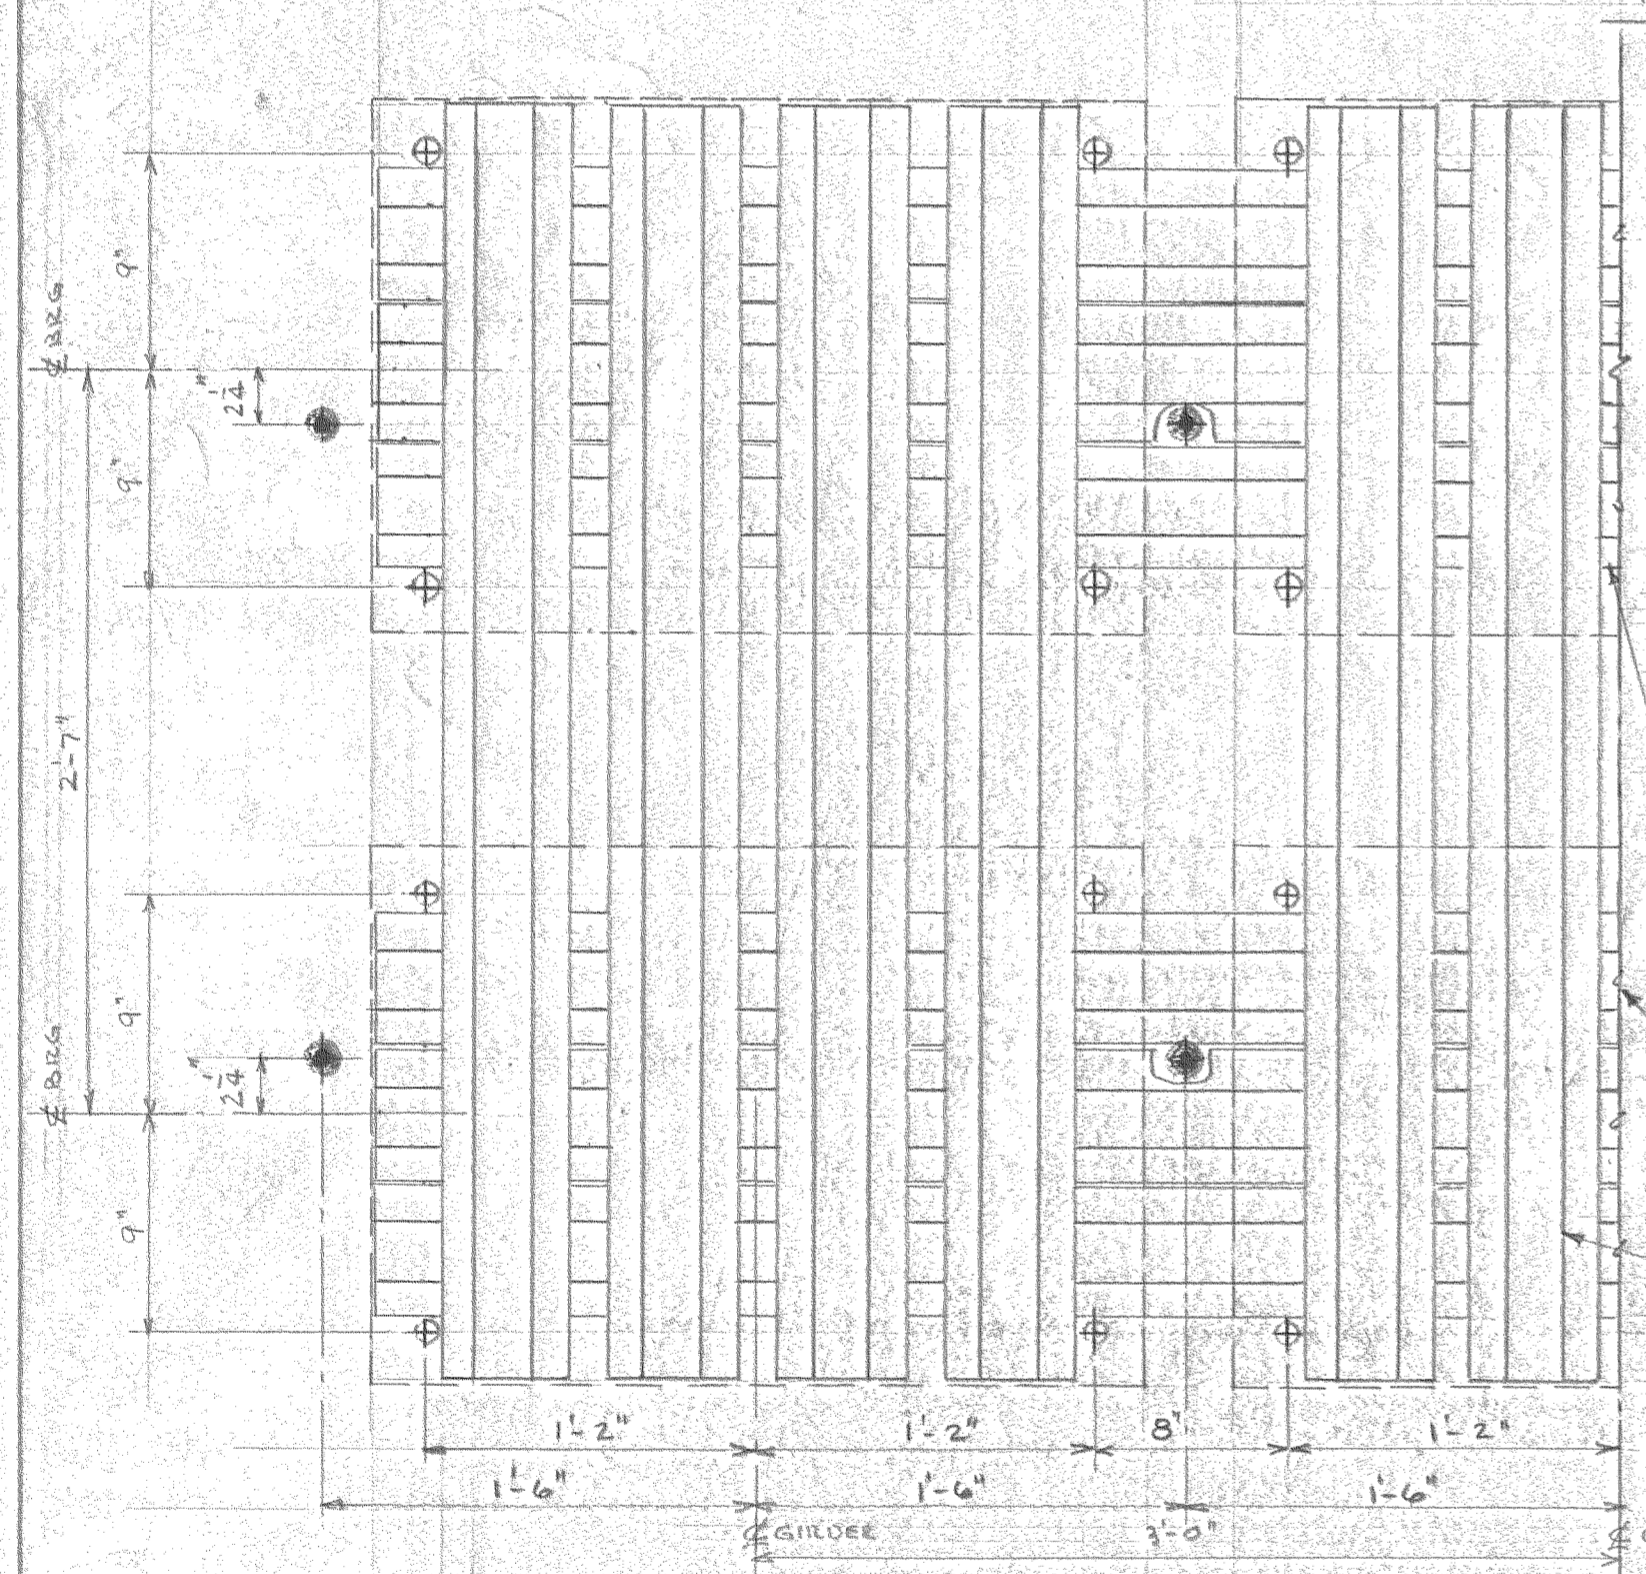


HALF PLAN AT PIERS 1 1/2" = 1'-0"

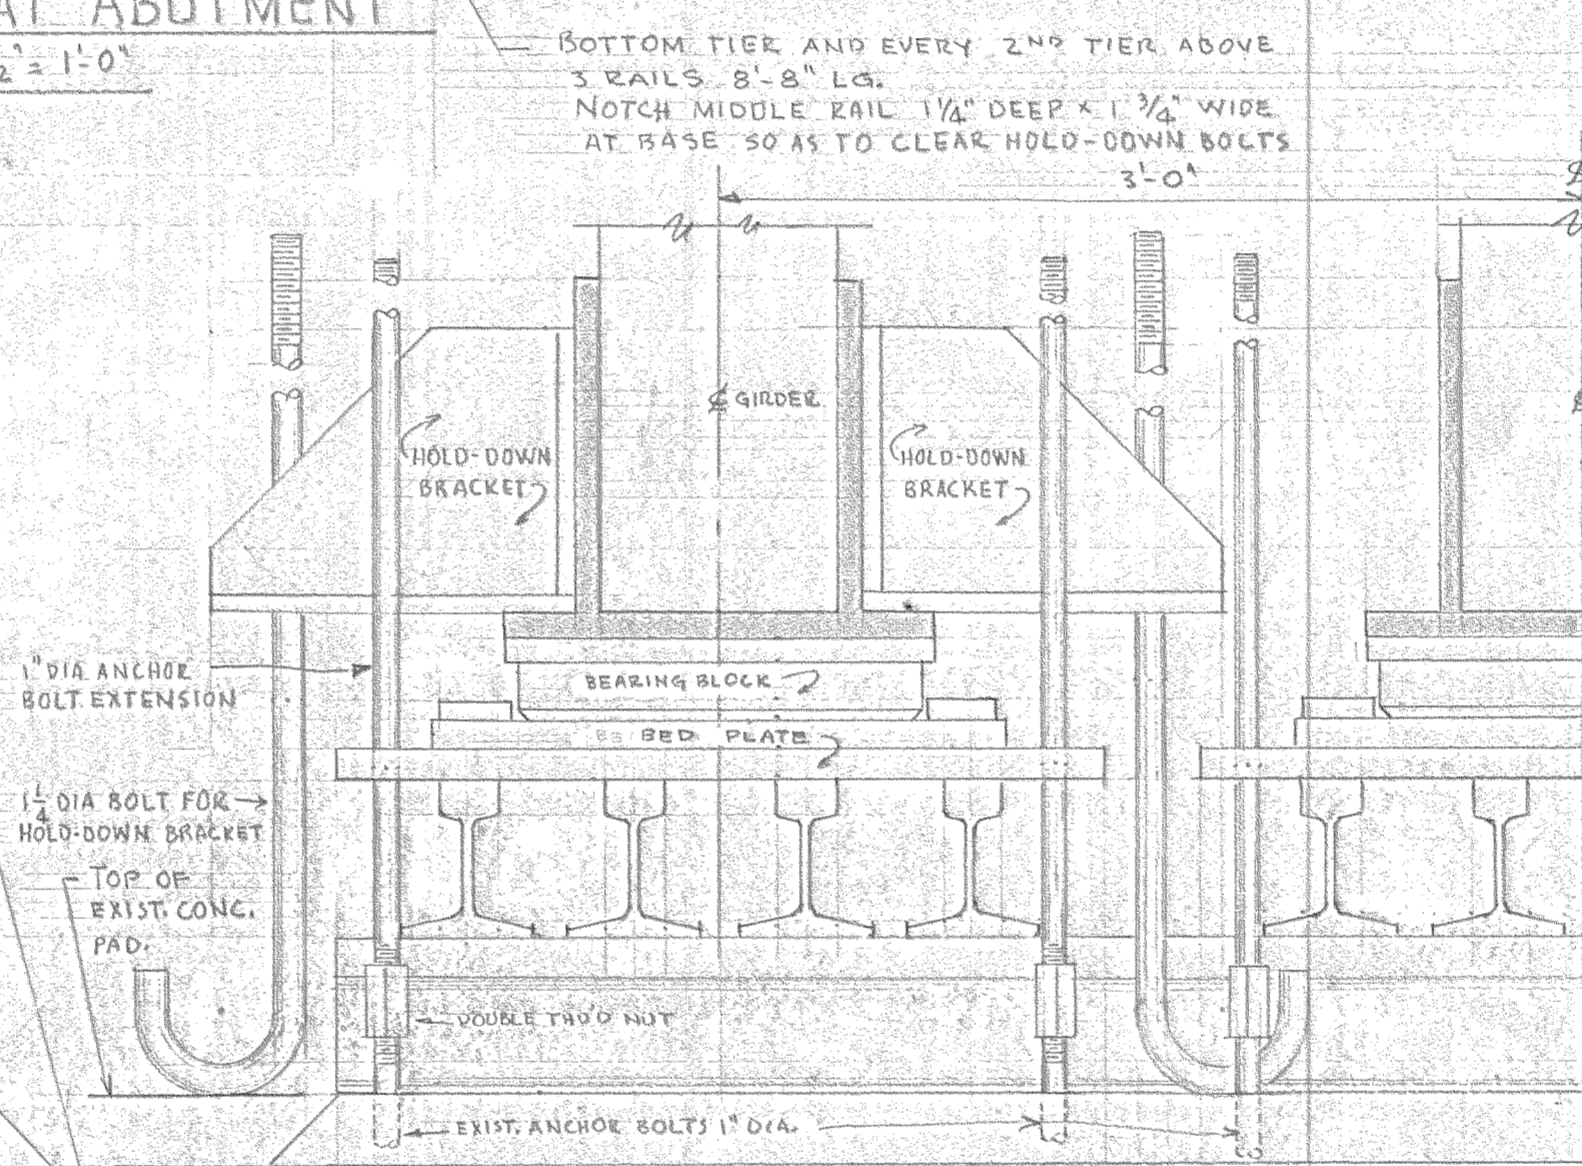

HALF END ELEVATION

SCALE: 1 1/2" = 1'-0"

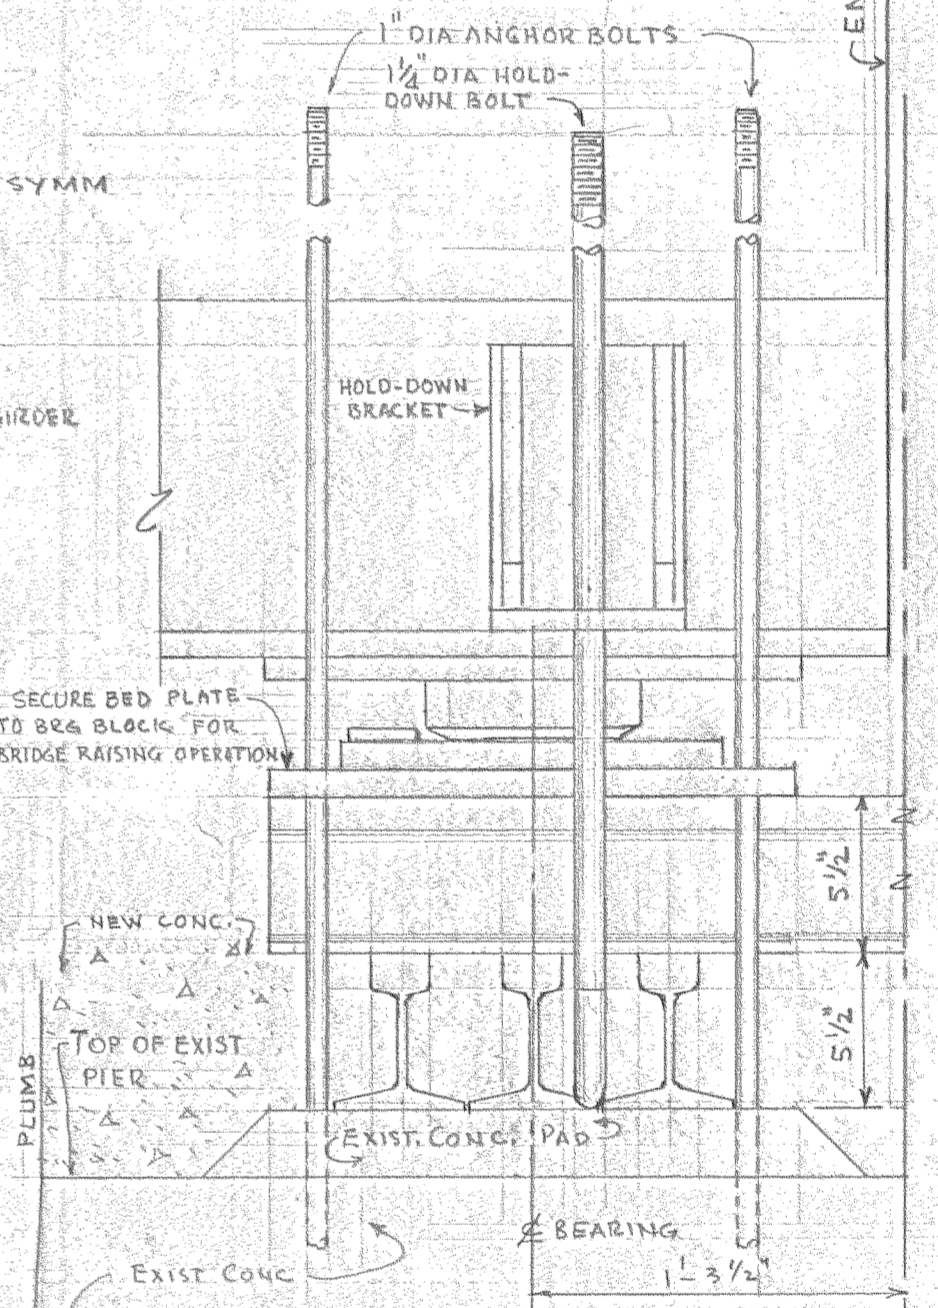



SIDE ELEVATION AT PIER
(ABUTMENT SIMILAR)

SCALE: 1 1/2" = 1'-0"








NOTES:

1. CRIBBING FOR RAISING OPERATION TO BE USED. 115 LB. RAIL PLANNED TO A HT. OF 6 1/2"
2. POUR CONC. AROUND CRIBS AFTER EVERY RAISE OF 13". EXTEND FACES OF PIERS & ABUTMENTS VERTICALLY
3. PLACE JACKS BEHIND BED PLATES & JACK ON BOTTOM OF GIRDER FLANGE OR UTILIZE JACKING ARRANGEMENT SHOWN ON SH. 1 OF 4, FILE NO. 64.7, DATED OCT. 1950
4. FOR DETAILS OF HOLD-DOWN BRACKETS SEE SEPARATE DRAWING
5. WELD RAILS FORMING CRIBBING TO EACH OTHER WHEREVER PRACTICAL

UNITED STATES DEPARTMENT OF THE INTERIOR THE ALASKA RAILROAD OFFICE OF THE CHIEF ENGINEER, ANCHORAGE	
RAISING DETAILS BRIDGE 64.7	
DRAWN BY RECOMMENDED	SCALE
ASST. CHIEF ENGINEER APPROVED	DATE:
CHIEF ENGINEER	FILE NO. 64.7

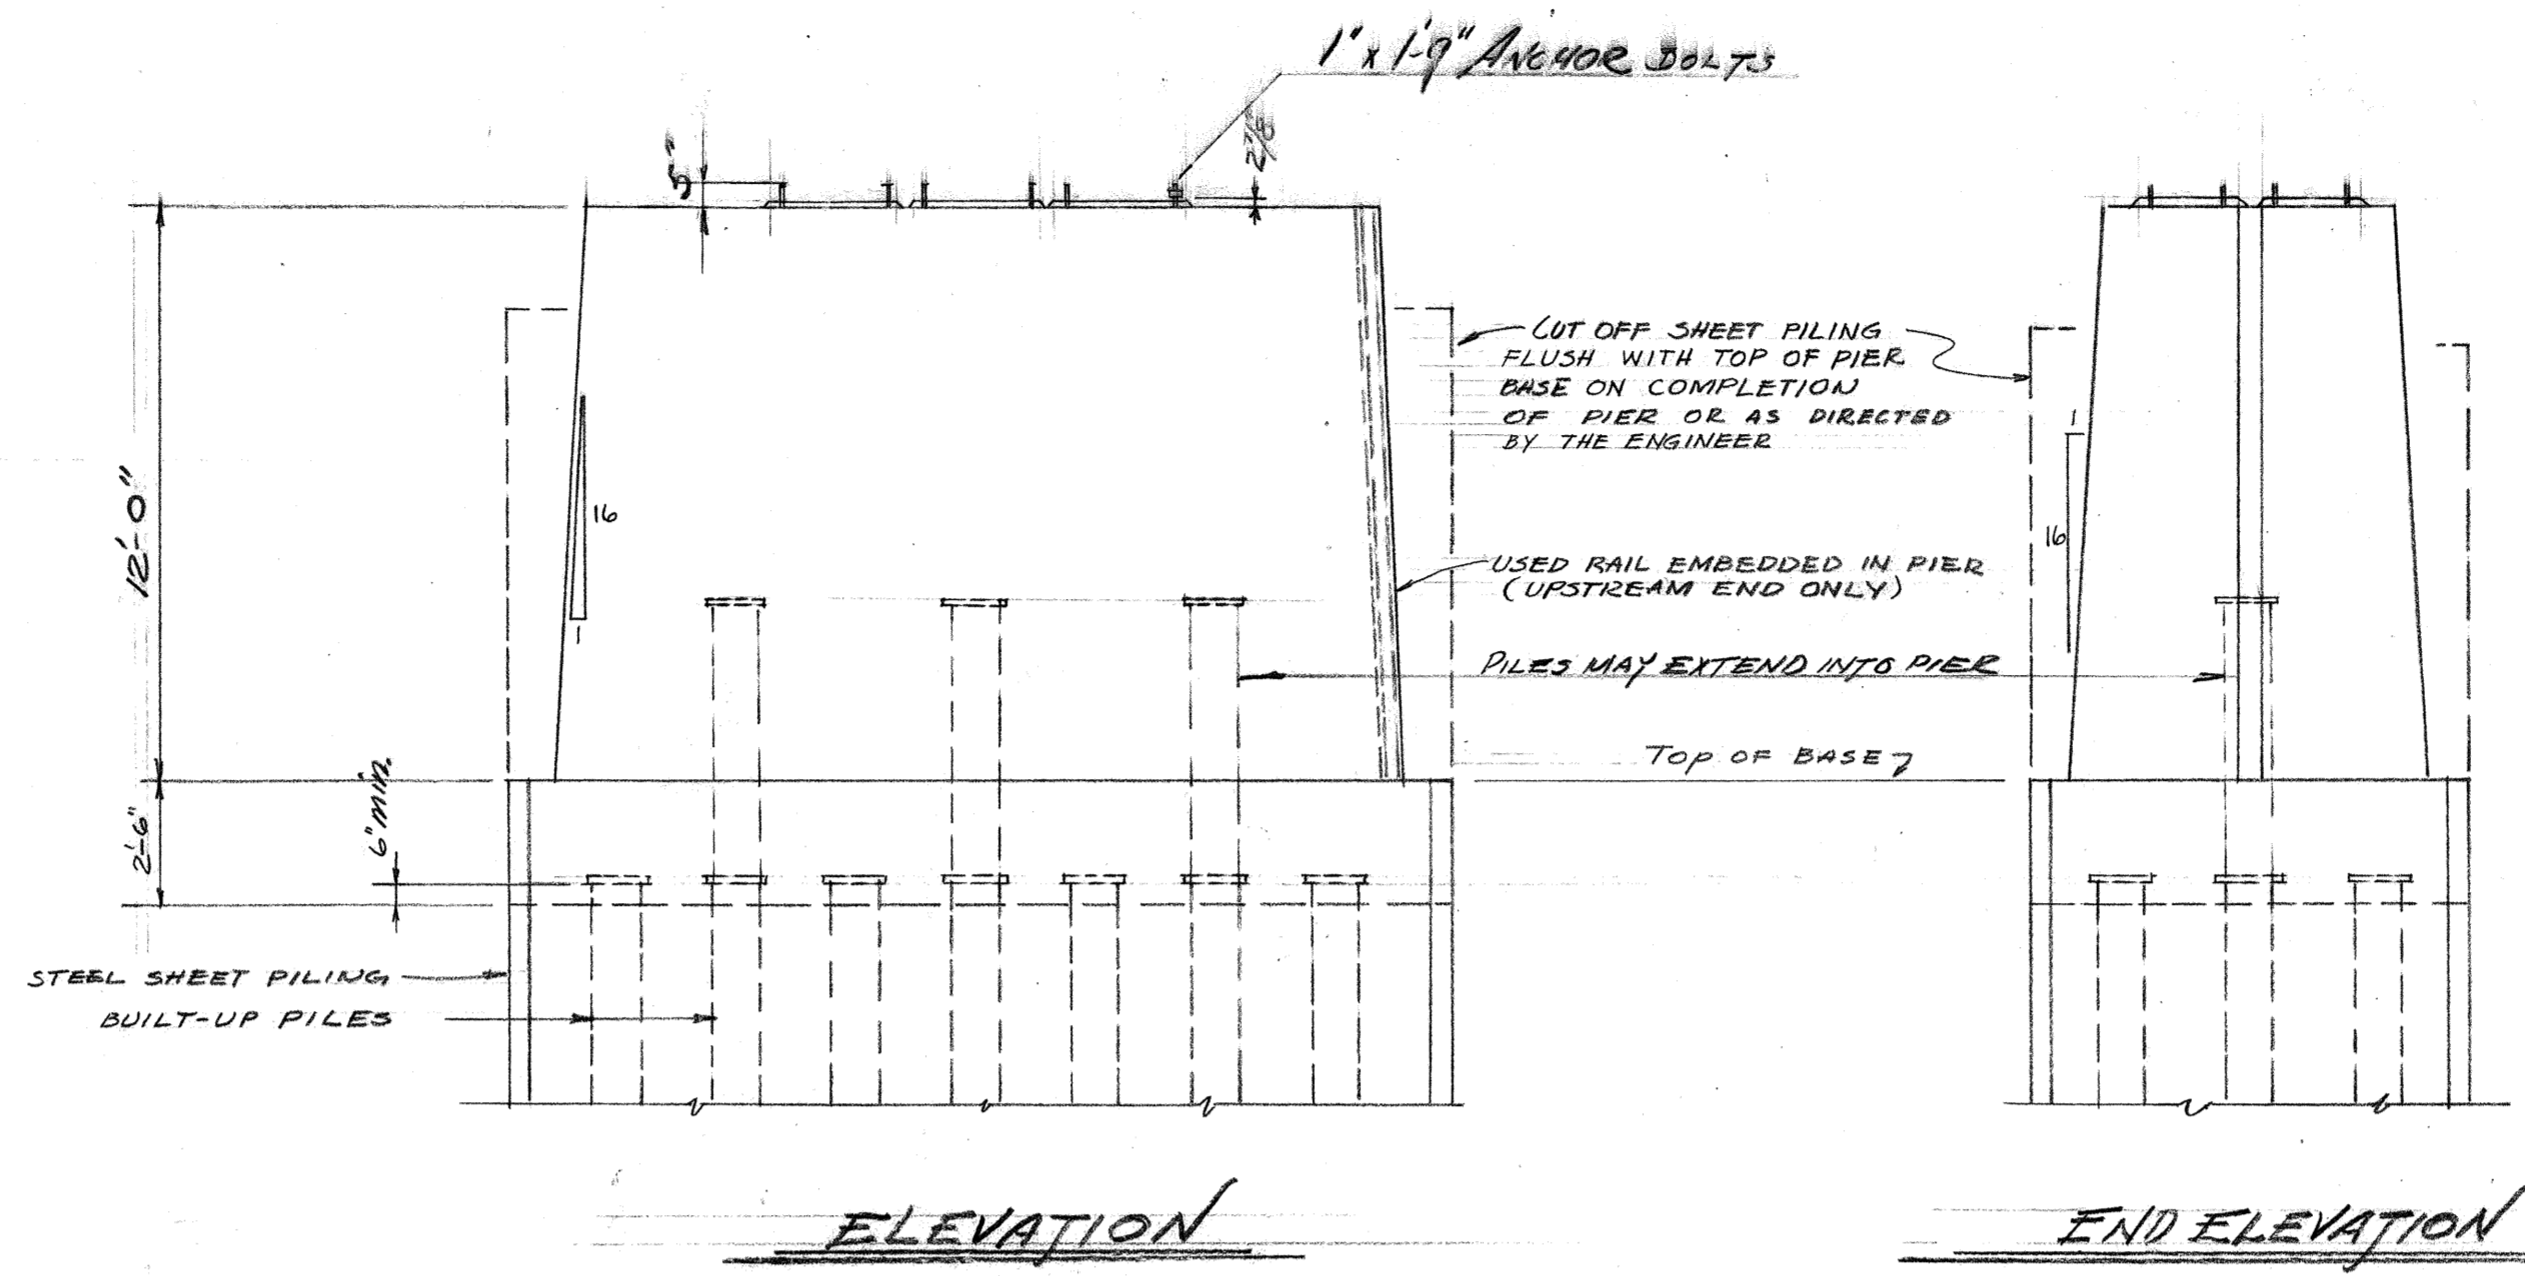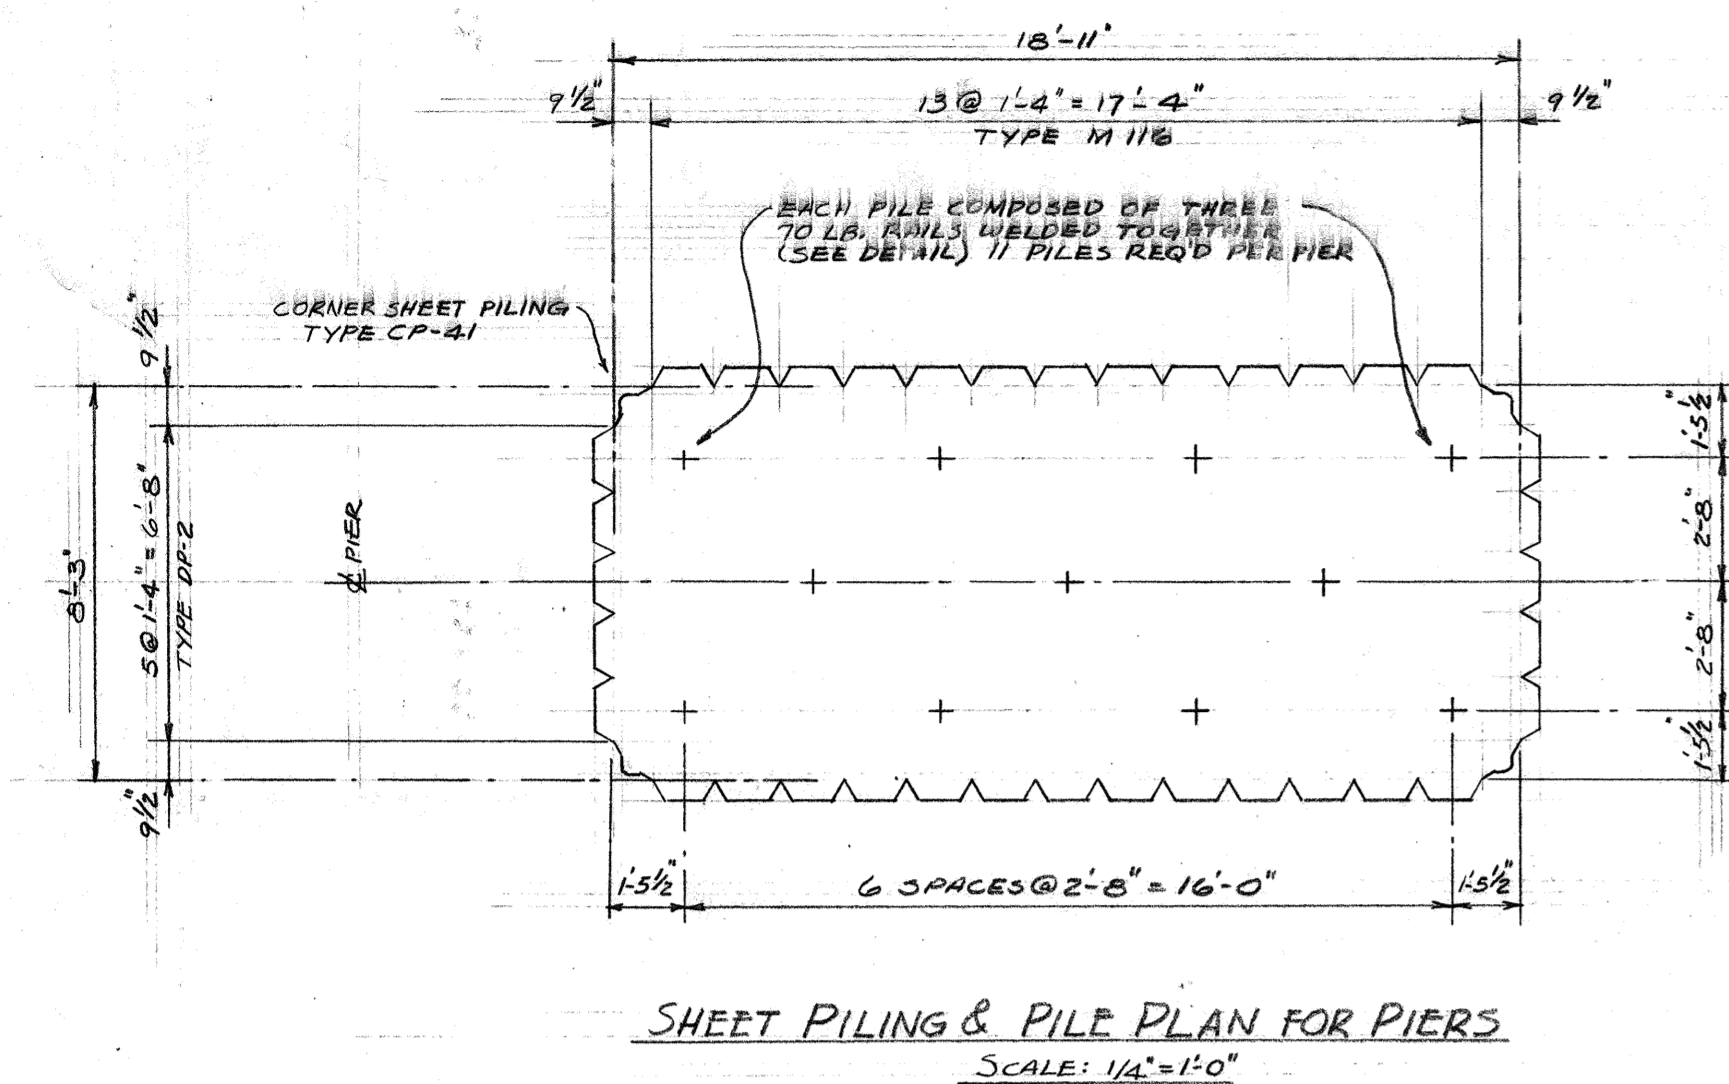


ESTIMATED QUANTITIES
ONE PIER
 59 cu. yd. CONCRETE
 1600 ft. 3/8" REINF BARS = 600 pounds
 40 - STEEL SHEET PILES 20 1/2" 28,800 pounds
 11 - FOUNDATION PILES 33" 27,200 "
 38 - cu. yd. EXCAVATION (APPROXIMATE AVERAGE)

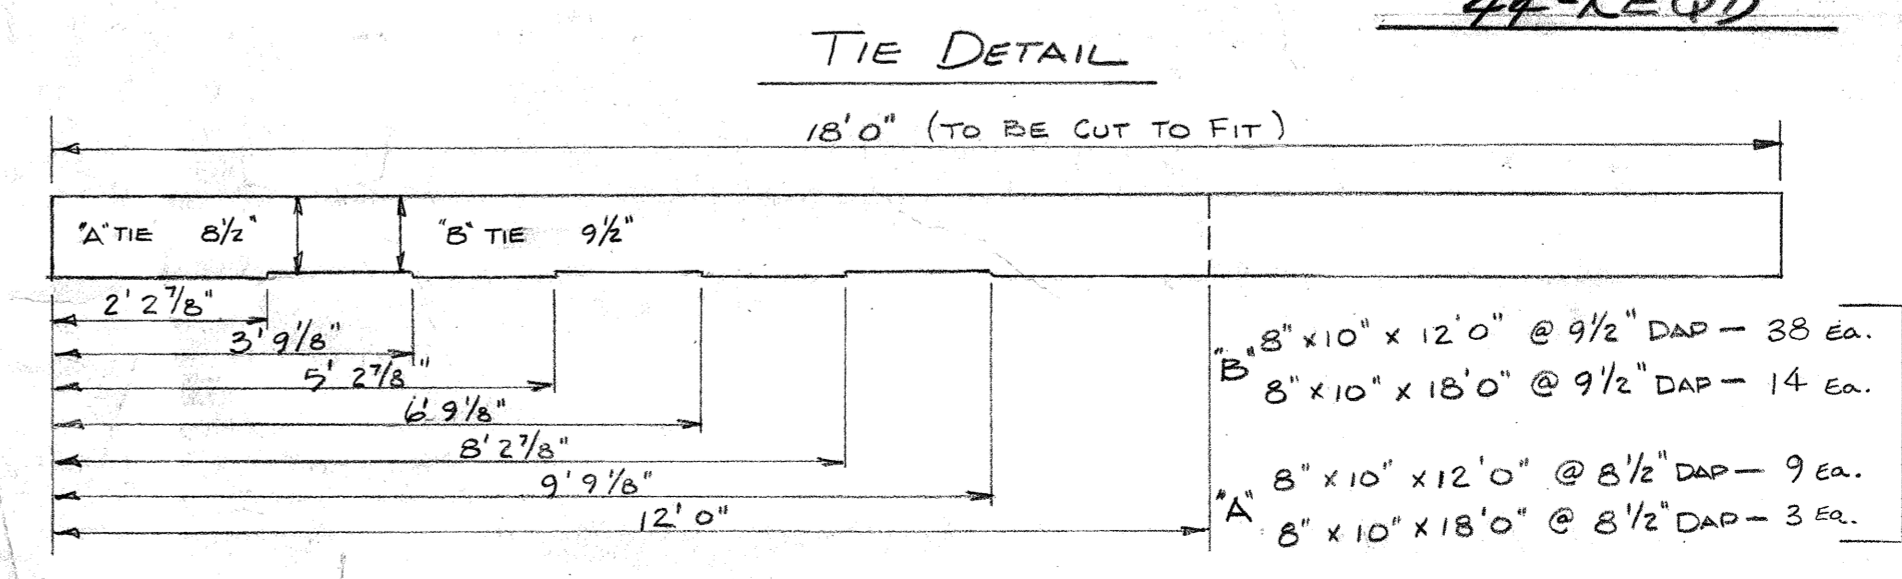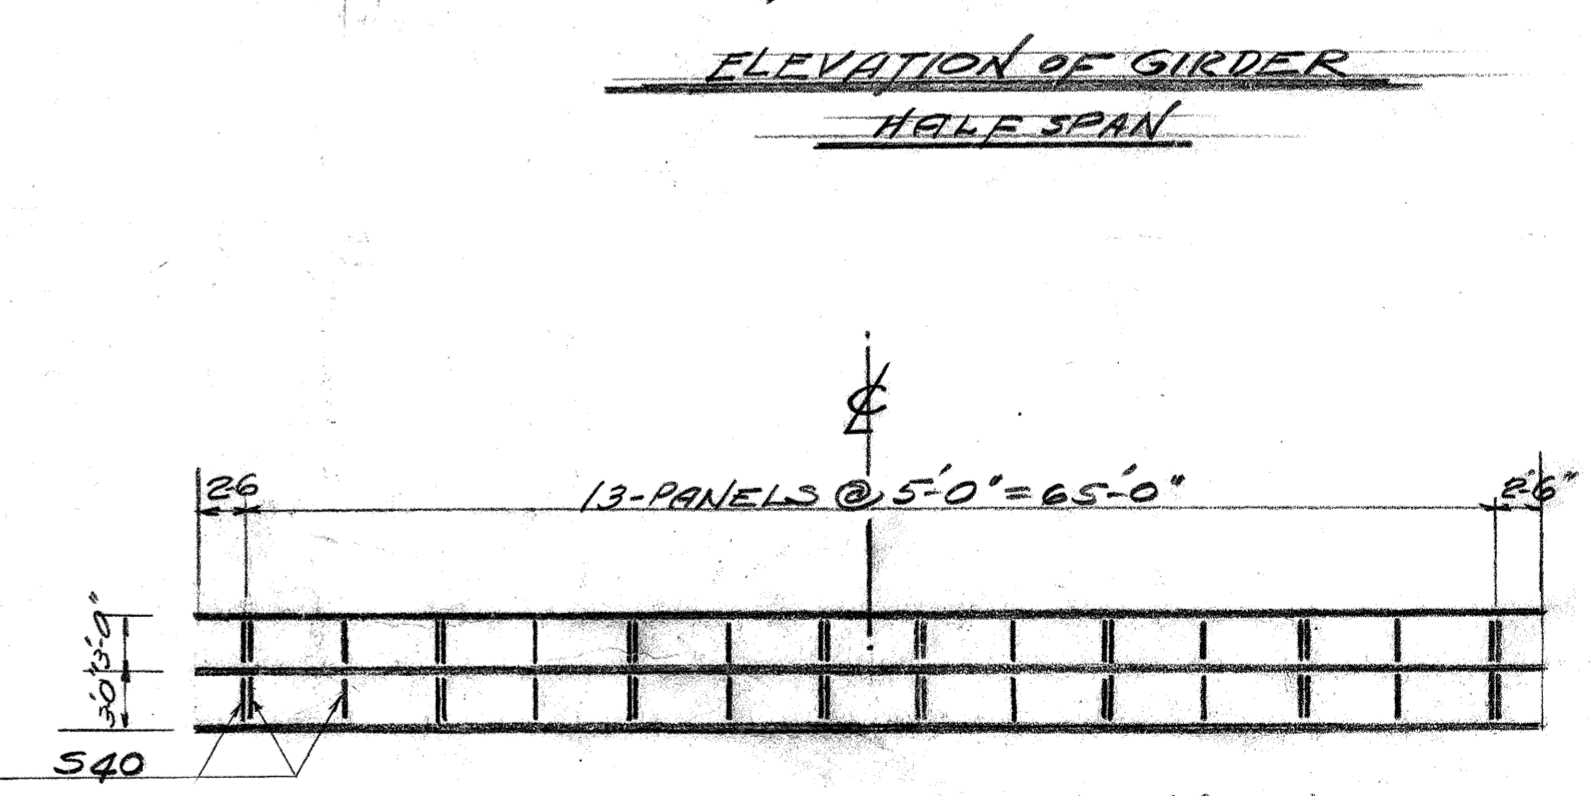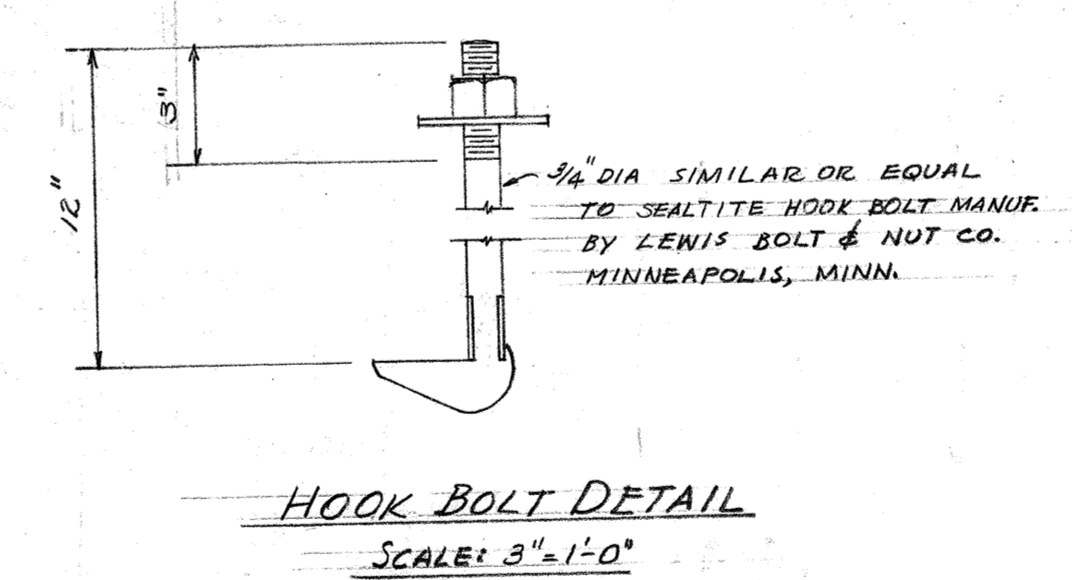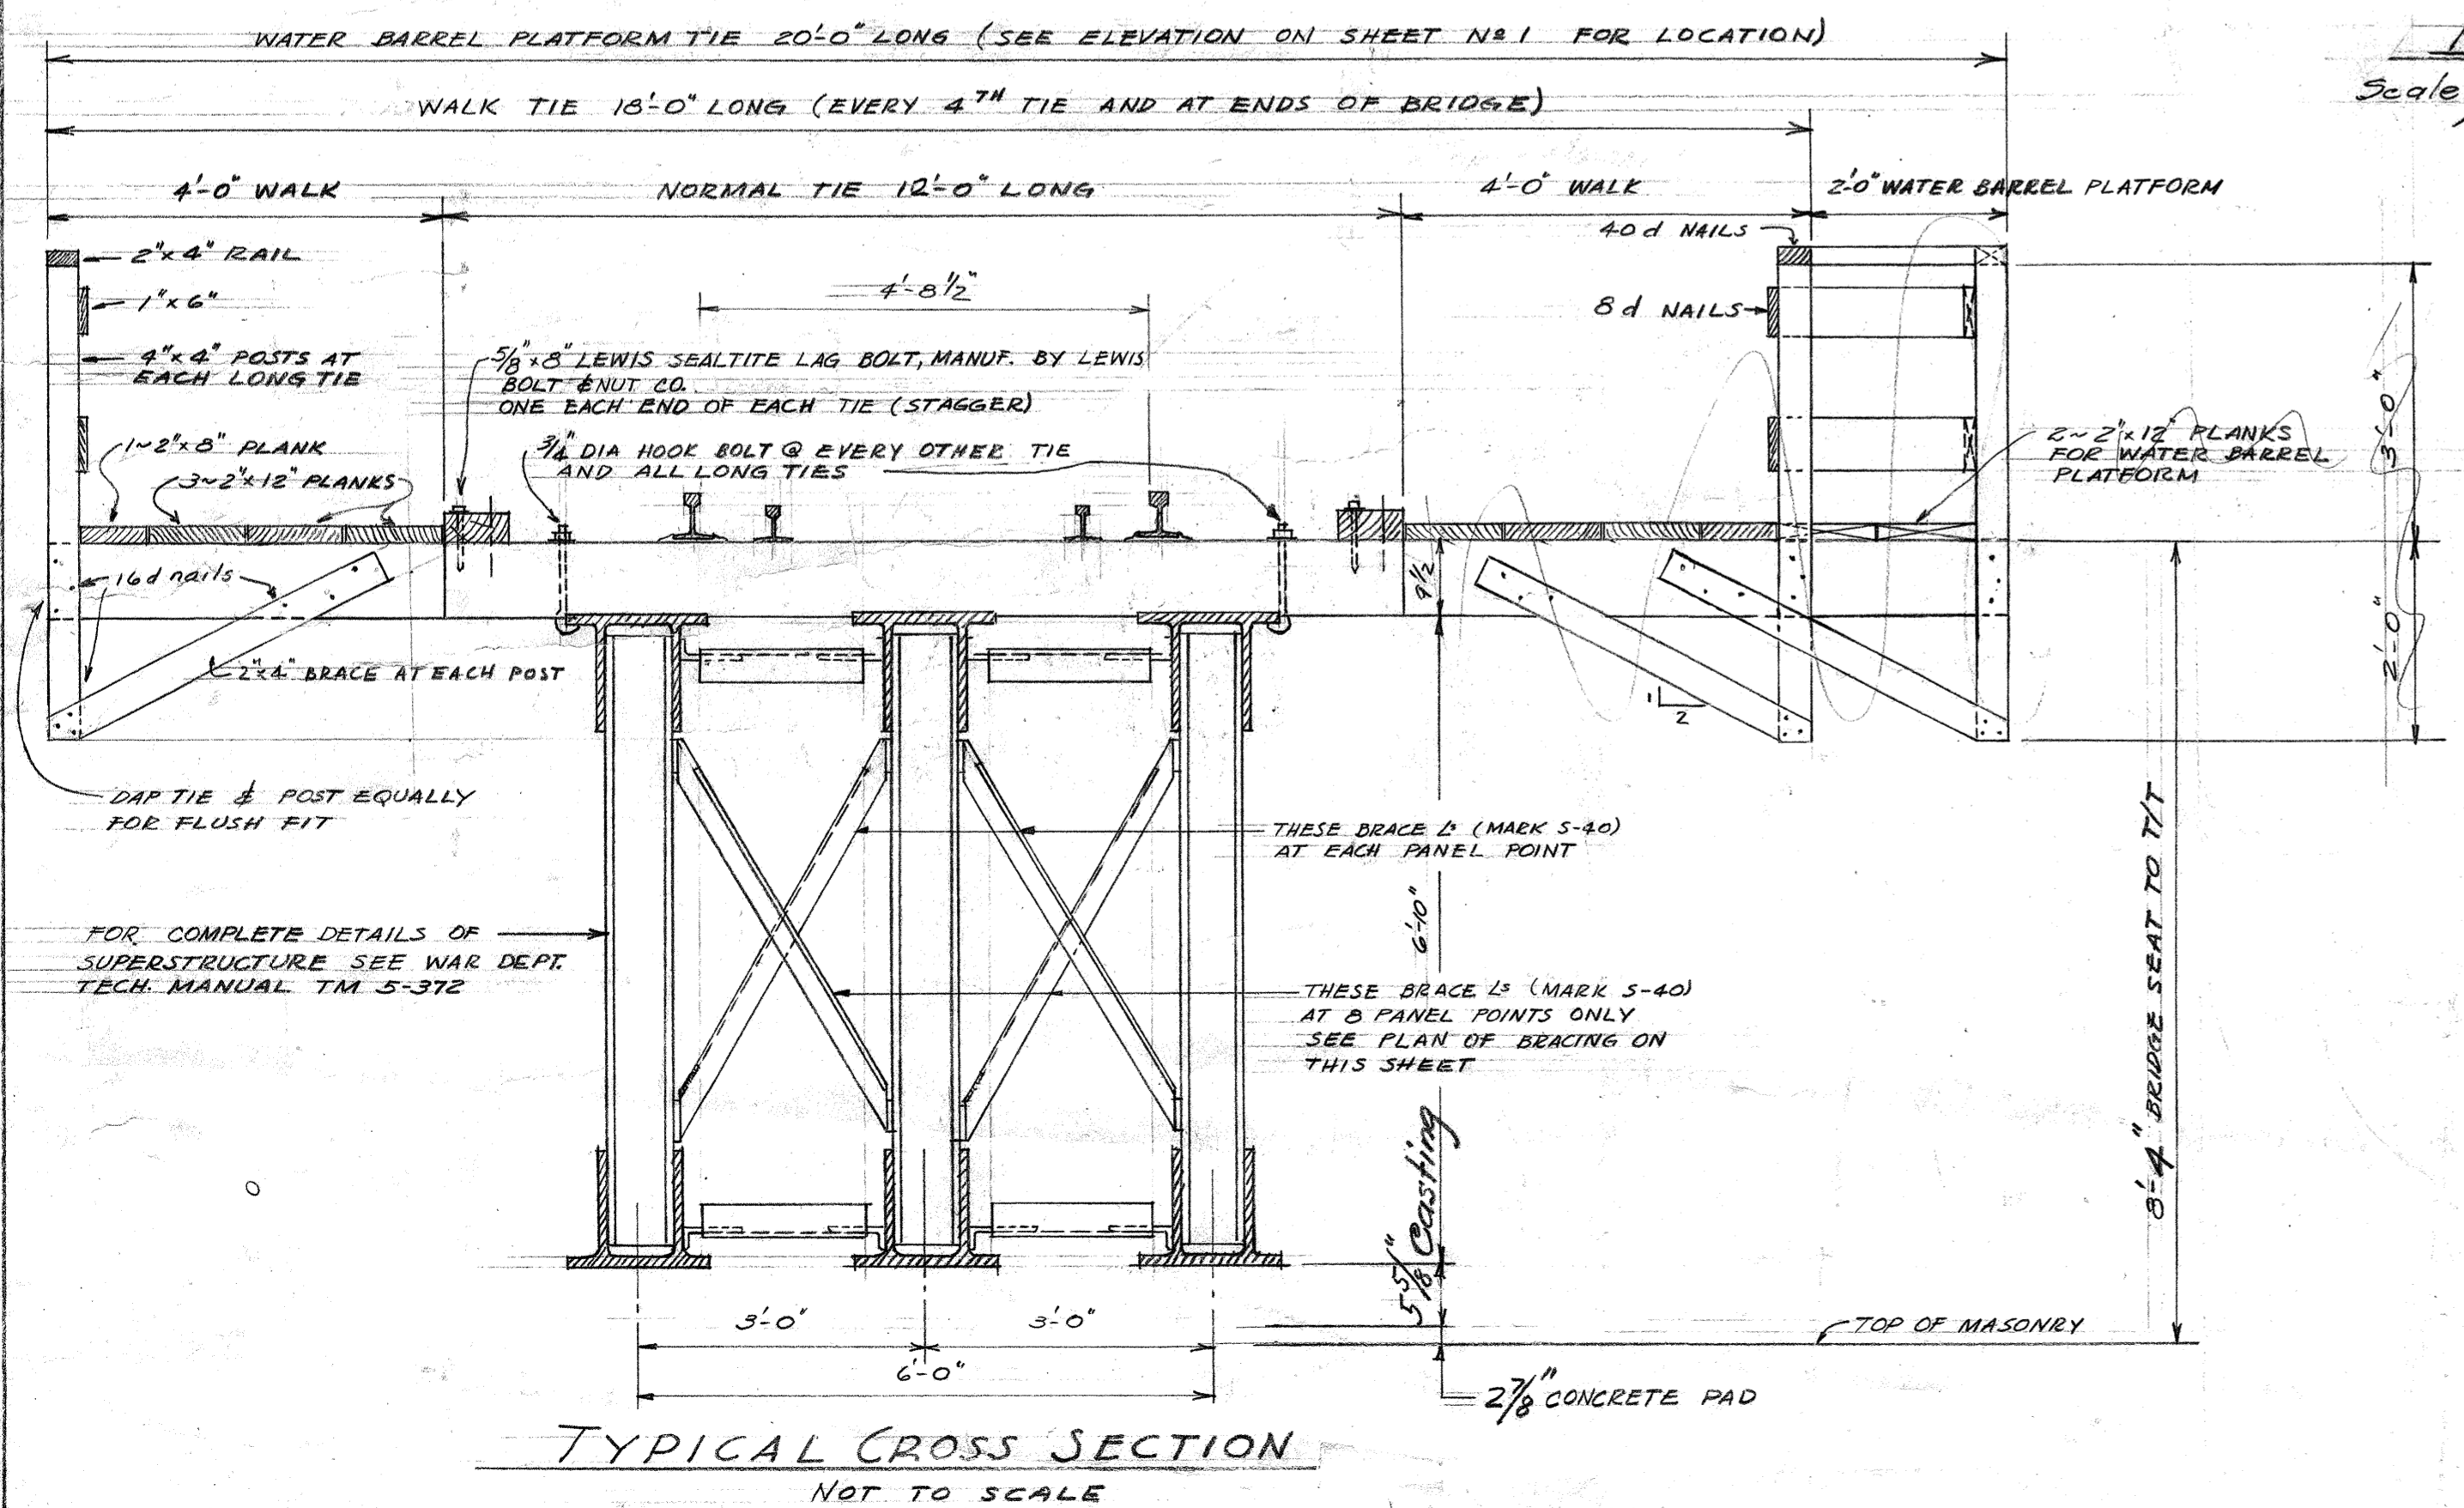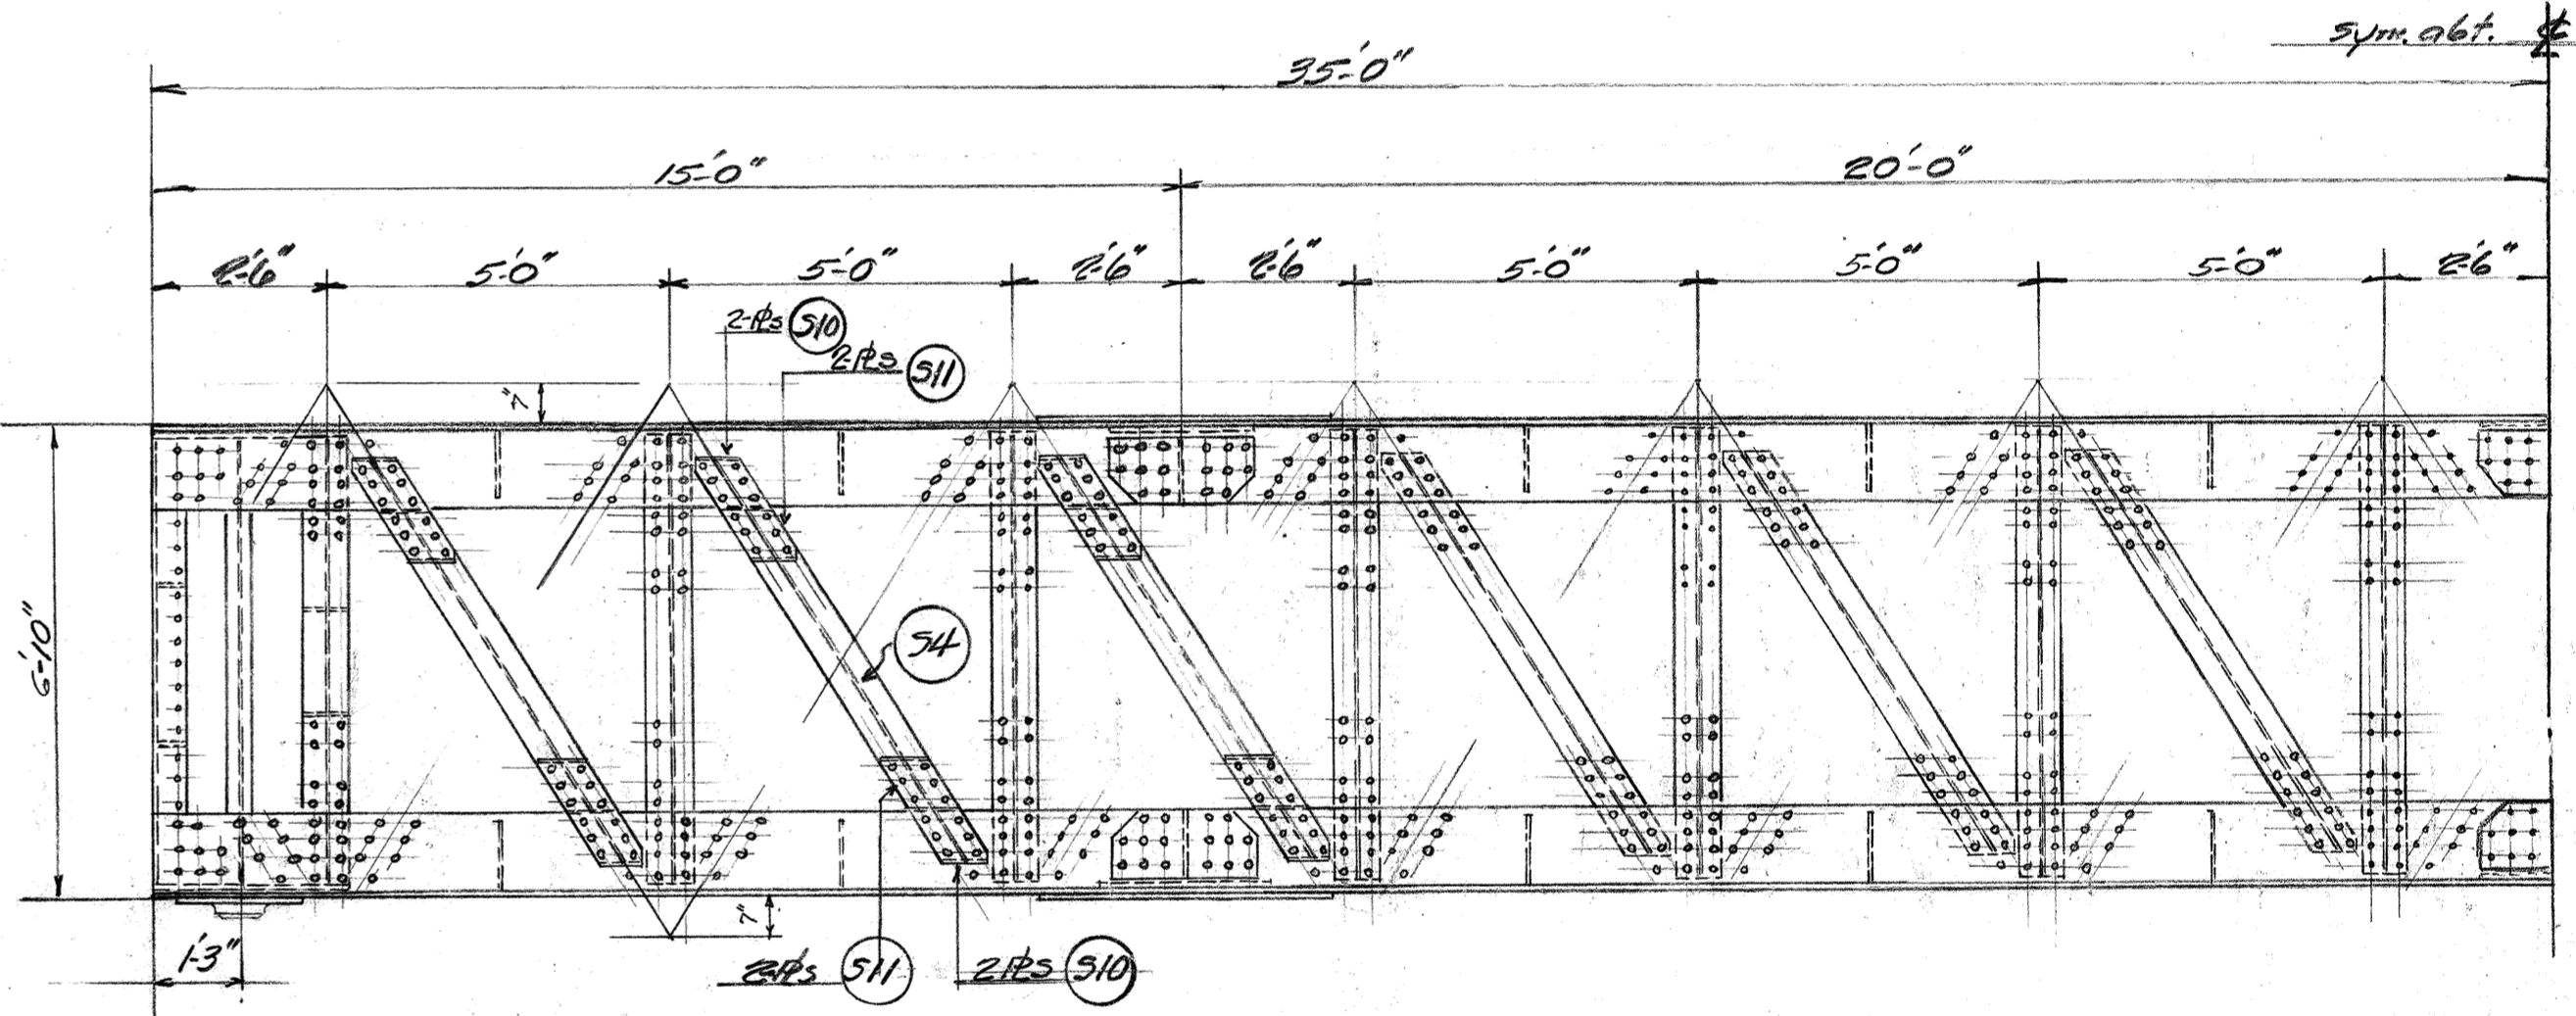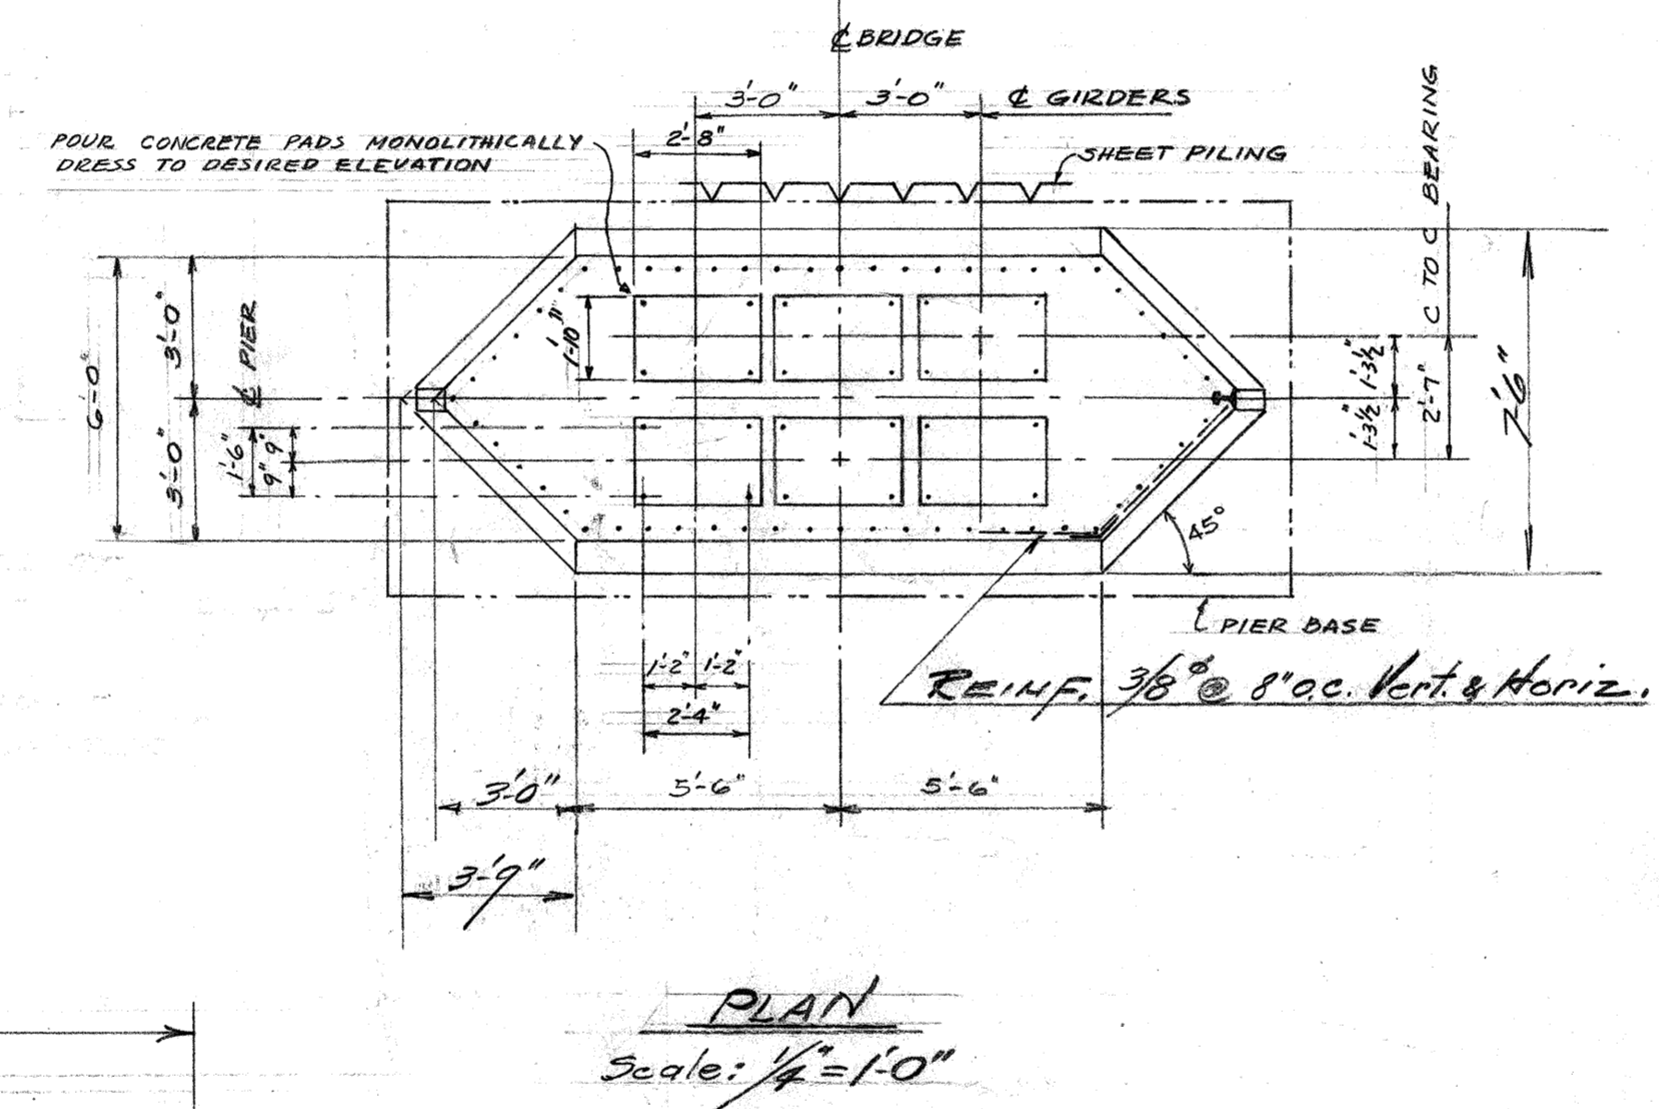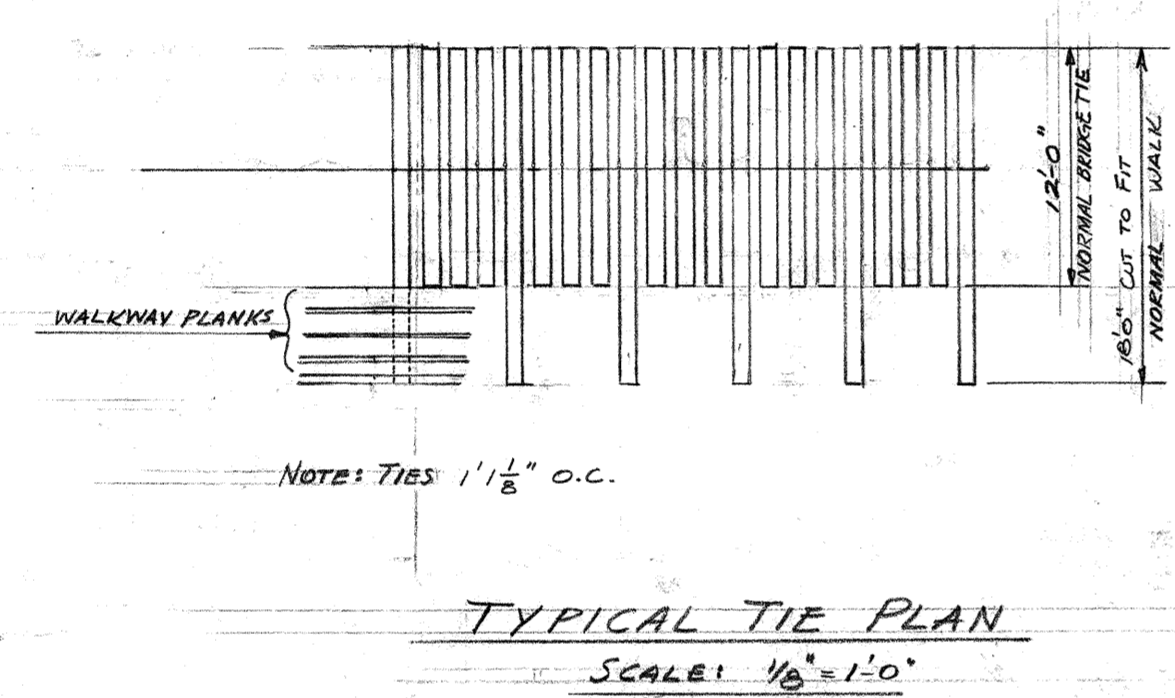


UNITED STATES DEPARTMENT OF THE INTERIOR
 THE ALASKA RAILROAD
 OFFICE OF THE CHIEF ENGINEER, ANCHORAGE
 BRIDGE 64.7-TWENTY MILE RIVER

DESIGNED: HOLMEN RECOMMENDED
 C. E. Smith
 ASSISTANT CHIEF ENGINEER
 APPROVED
 R. A. Rasmussen
 CHIEF ENGINEER


SCALE: AS SHOWN
 DATE: Oct. 1950
 FILE NO. 64.7

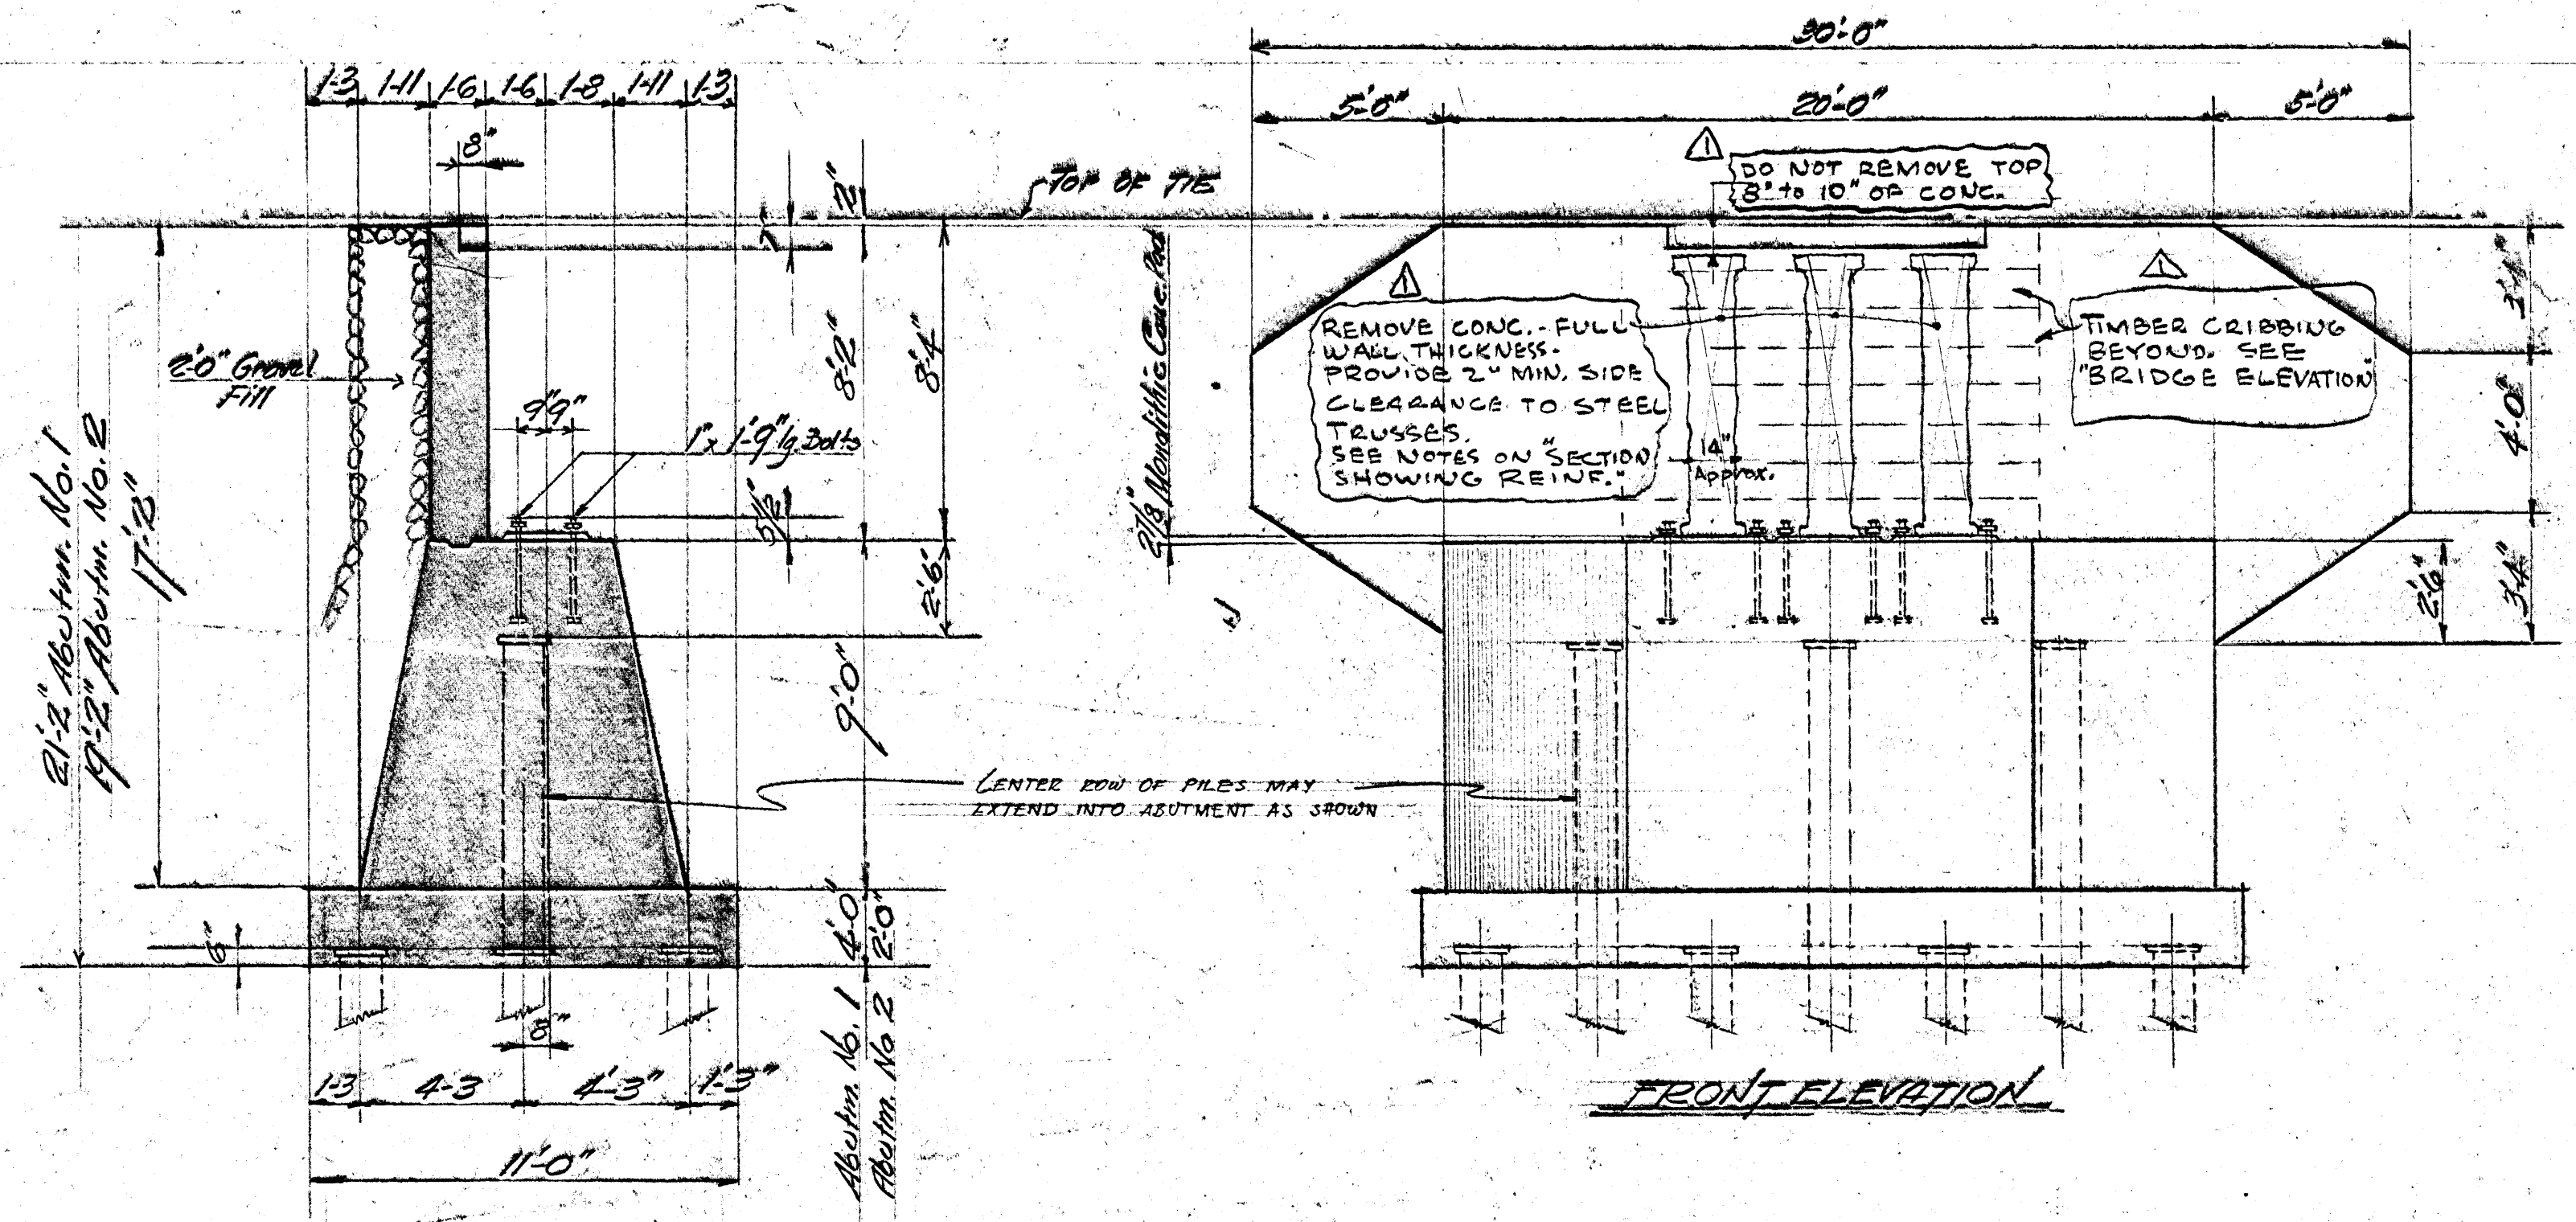


SECTION ON C
Scale: 1/4"=1'-0"

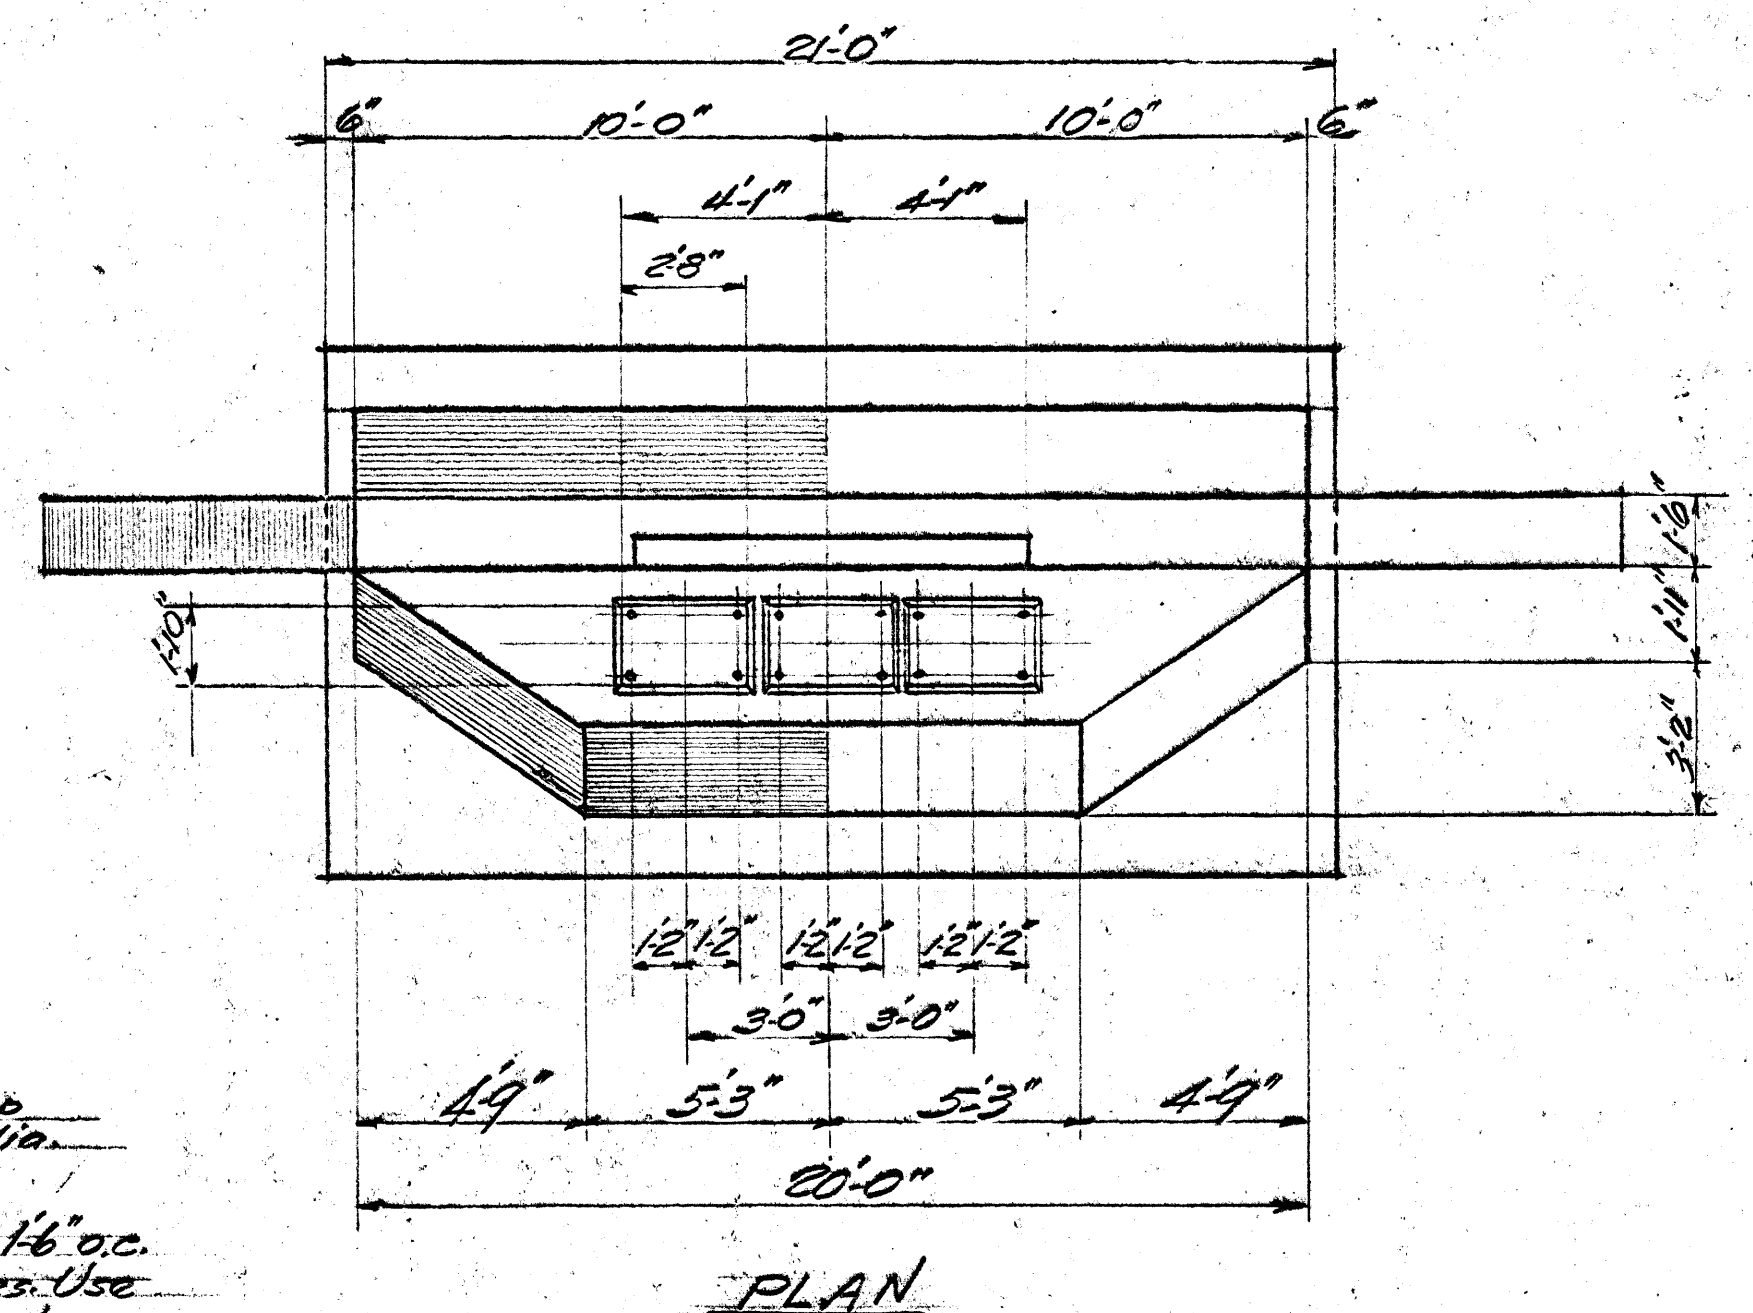


PLAN

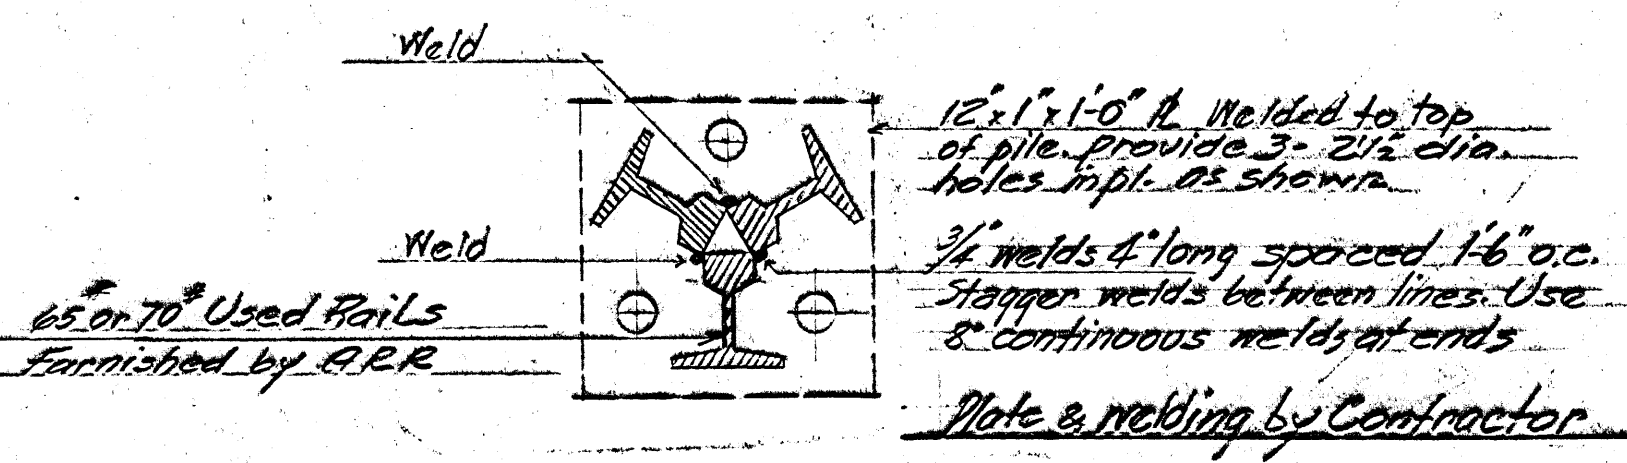

CROSS-SECTION OF PILE
Scale: 1/4"=1'-0"

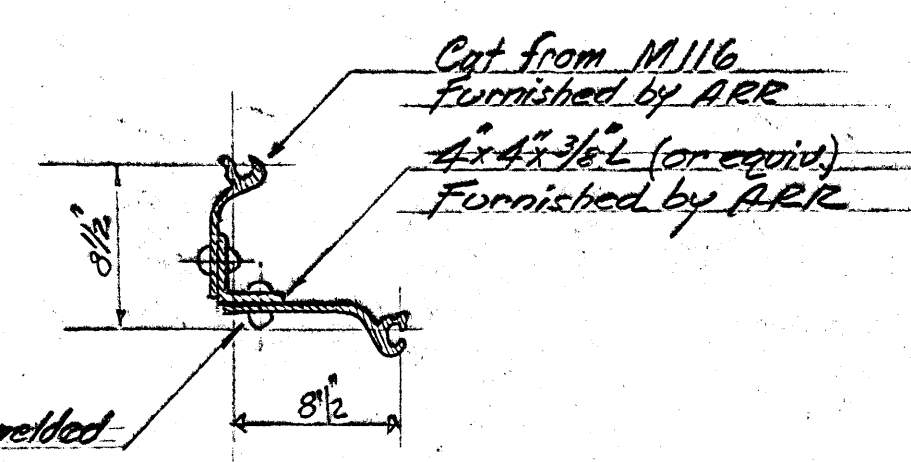


CORNER PILE FOR COFFERDAMS
24 CORNER SHEETS REQ'D. IN TOTAL - 2 TO BE MADE UP AS SHOWN ABOVE (BY CONTRACTOR)

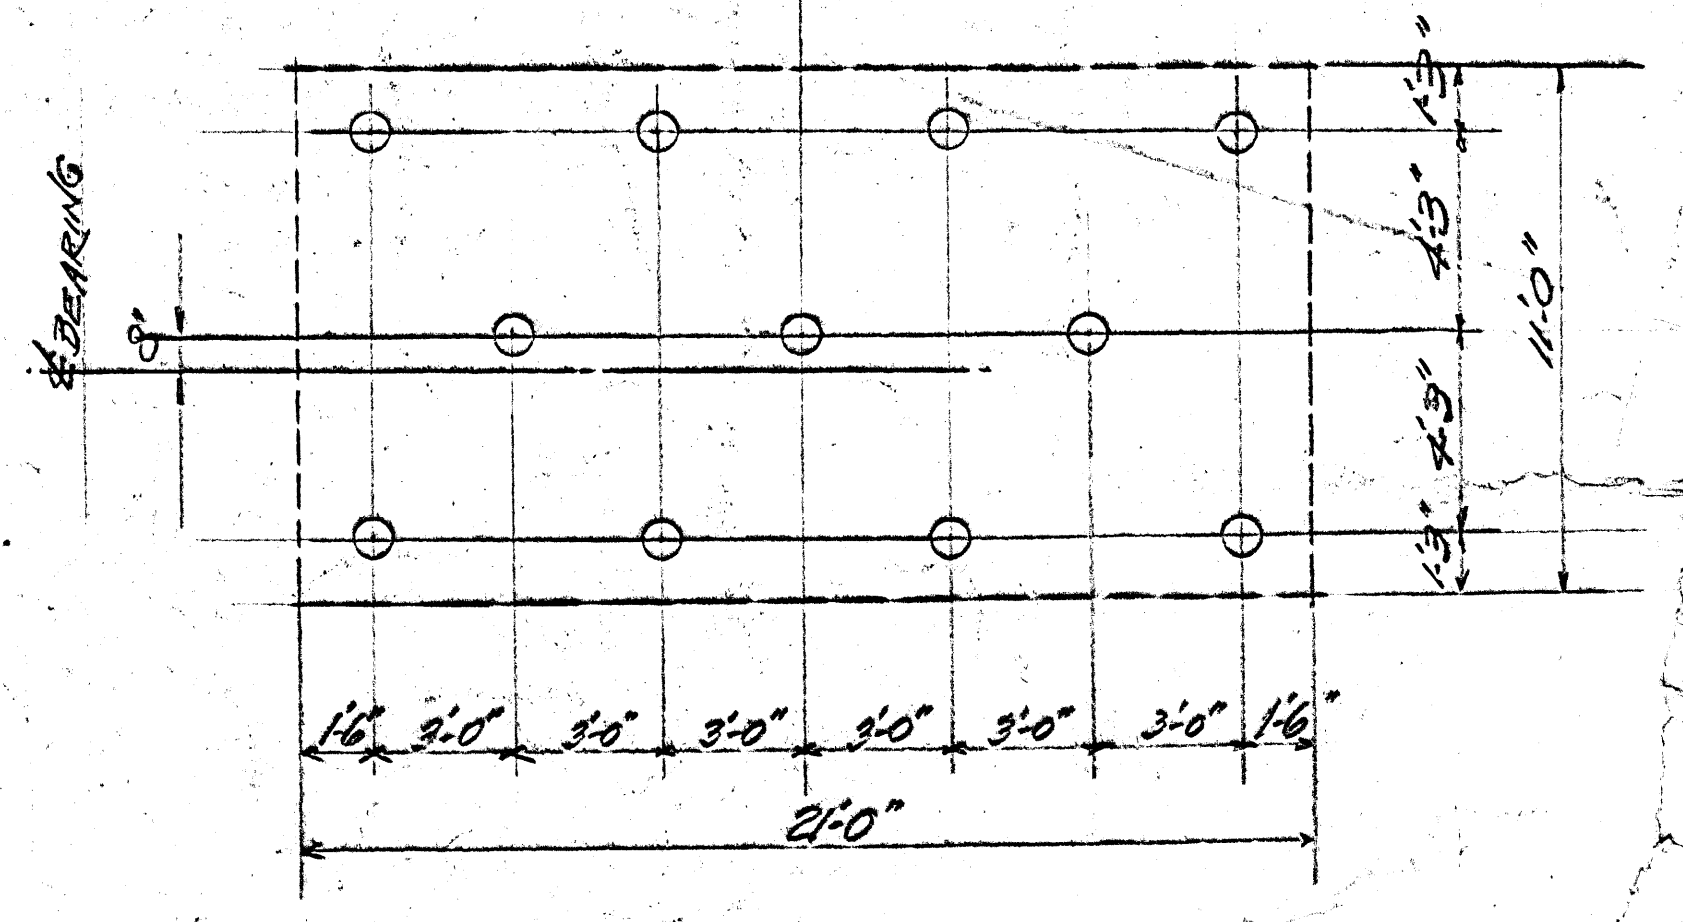


PILE PLAN


END ELEVATION

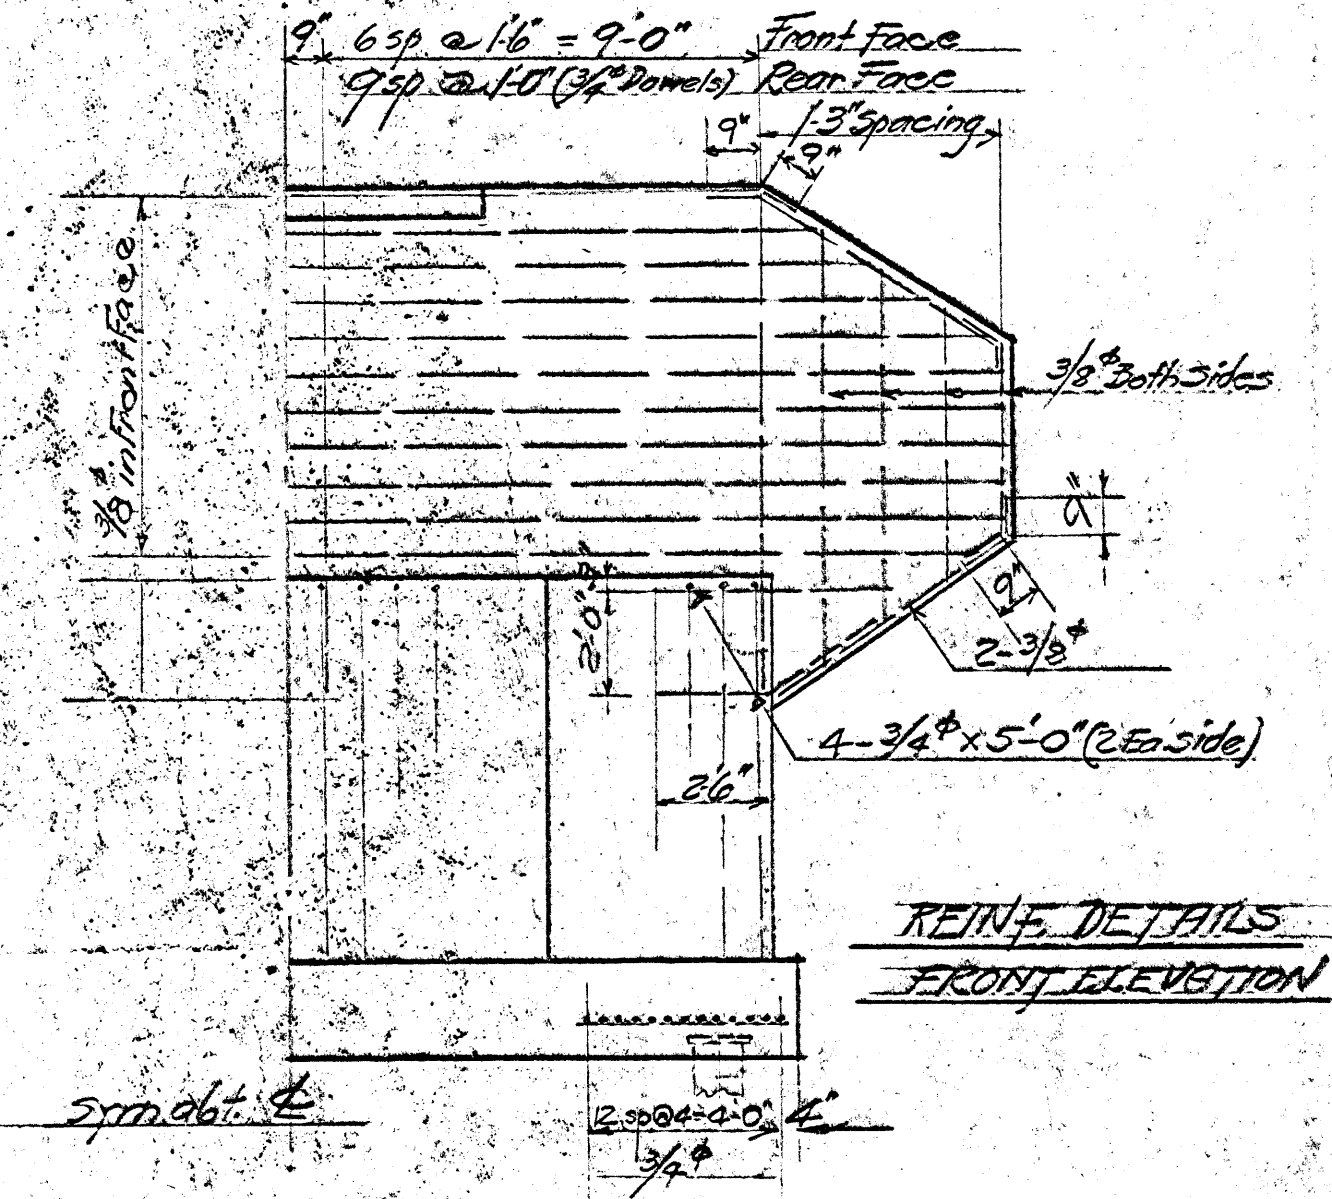

REINFC. DETAILS
FRONT ELEVATION

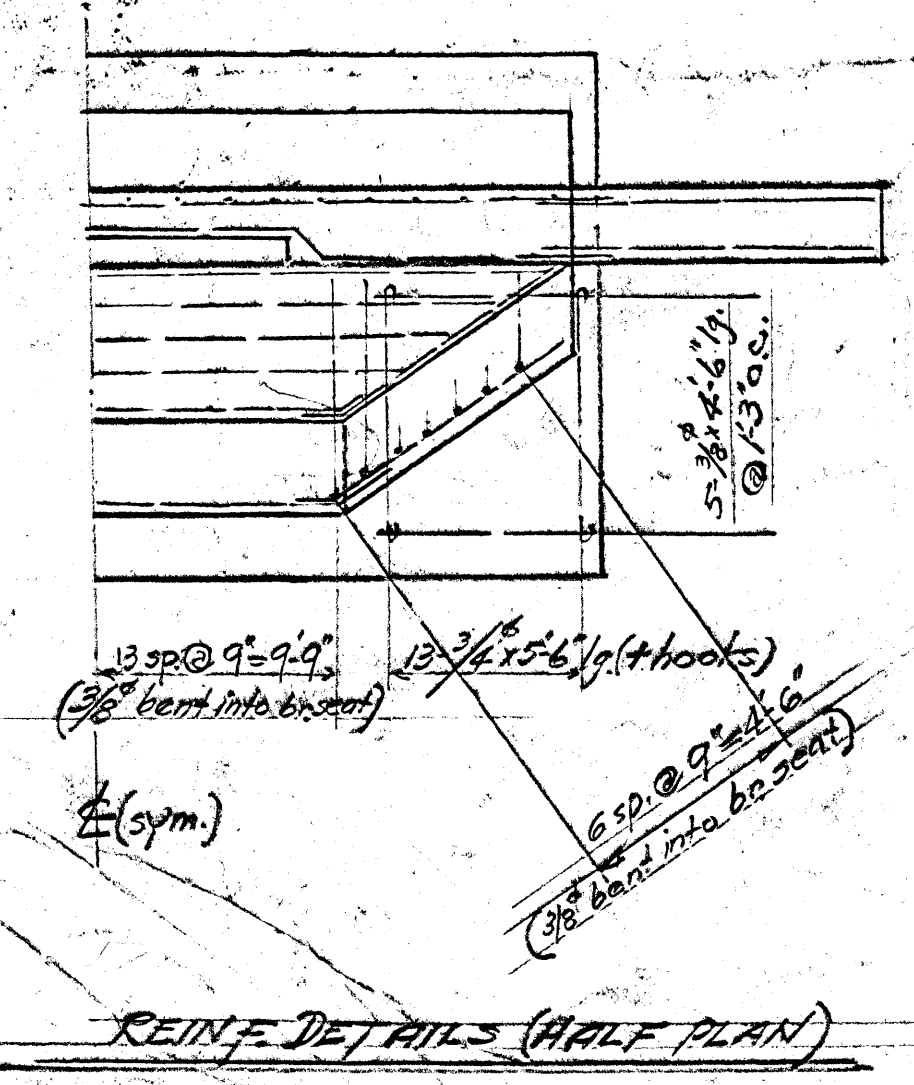

REINFC. DETAILS (HALF PLAN)

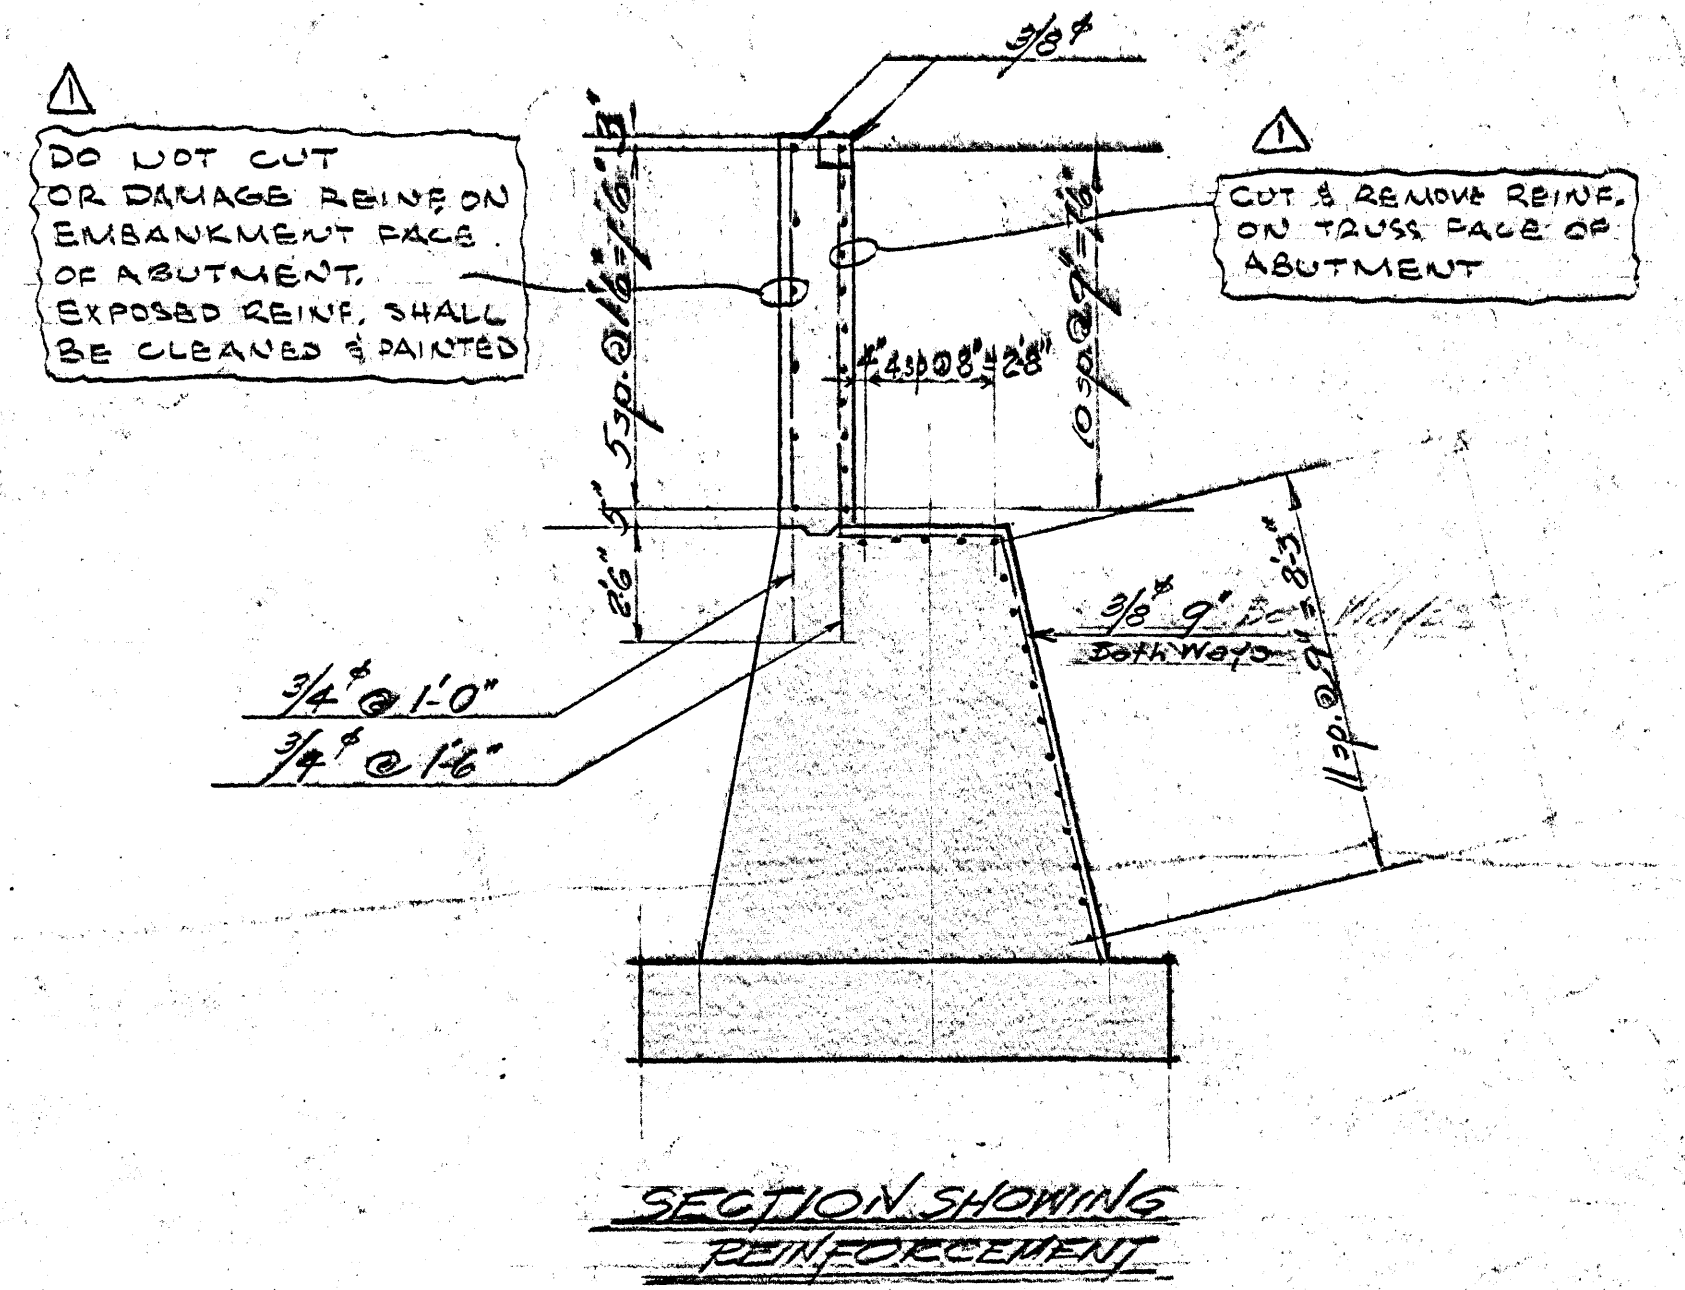


SECTION SHOWING REINFORCEMENT


ESTIMATED QUANTITIES	
ABUTMENT NO. 1	
11- FOUNDATION PILES 33 FT. LG.	25,500 lb.
11- CAP PLATES FOR PILES 12x1x10"	450 "
CONCRETE	85.5 cu. yd.
REINFORCING BARS	
3/4"	580 ft. - 870 lb.
3/8"	1200' - 450 "
TOTAL REINF.	1320 lb.
ABUTMENT NO. 2	
11- FOUNDATION PILES 33 FT. LG.	25,500 lb.
11- CAP PLATES FOR PILES 12x1x10"	450 "
CONCRETE	68.5 cu. yd.
REINFORCING BARS	
3/4"	580 ft. - 870 lb.
3/8"	1200' - 450 "
TOTAL REINF.	1320 lb.

NOTES: BOTH ABUTMENTS BUILT EXCEPT FOR DEPTH OF FOOTINGS


20 MILE RIVER BRIDGE
UNITED STATES DEPARTMENT OF THE INTERIOR
THE ALASKA TERRITORY
OFFICE OF THE CHIEF ENGINEER, ENCHARGE
BRIDGE NO. 647
ABUTMENT NO. 1 & 2
Designed: H. L. Mann
Recommended: R. E. Conroy
Resident Chief Engineer
Approved: R. A. Johnson
Chief Engineer
Scale: 1/4" = 1'-0"
October, 1950
FILE: 647

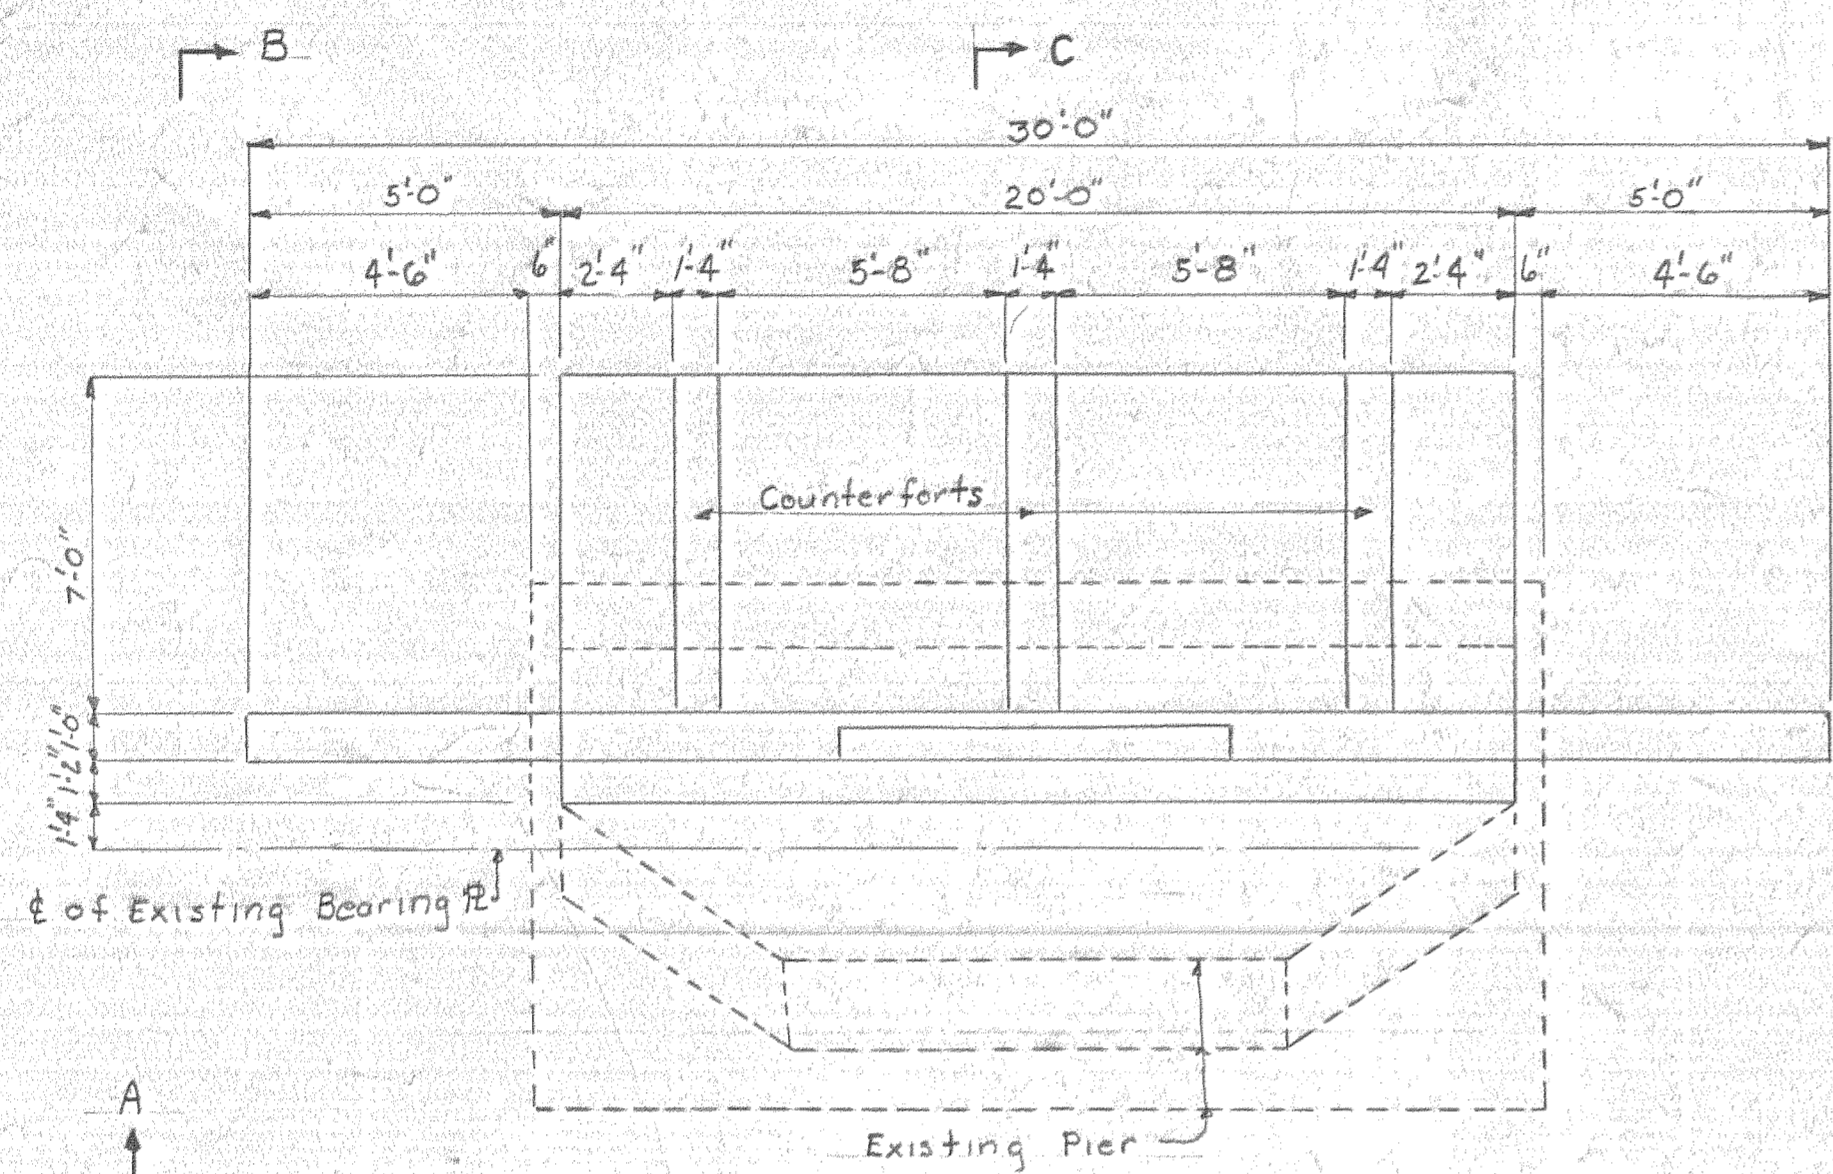


PLAN
Scale 1/4" = 1'-0"

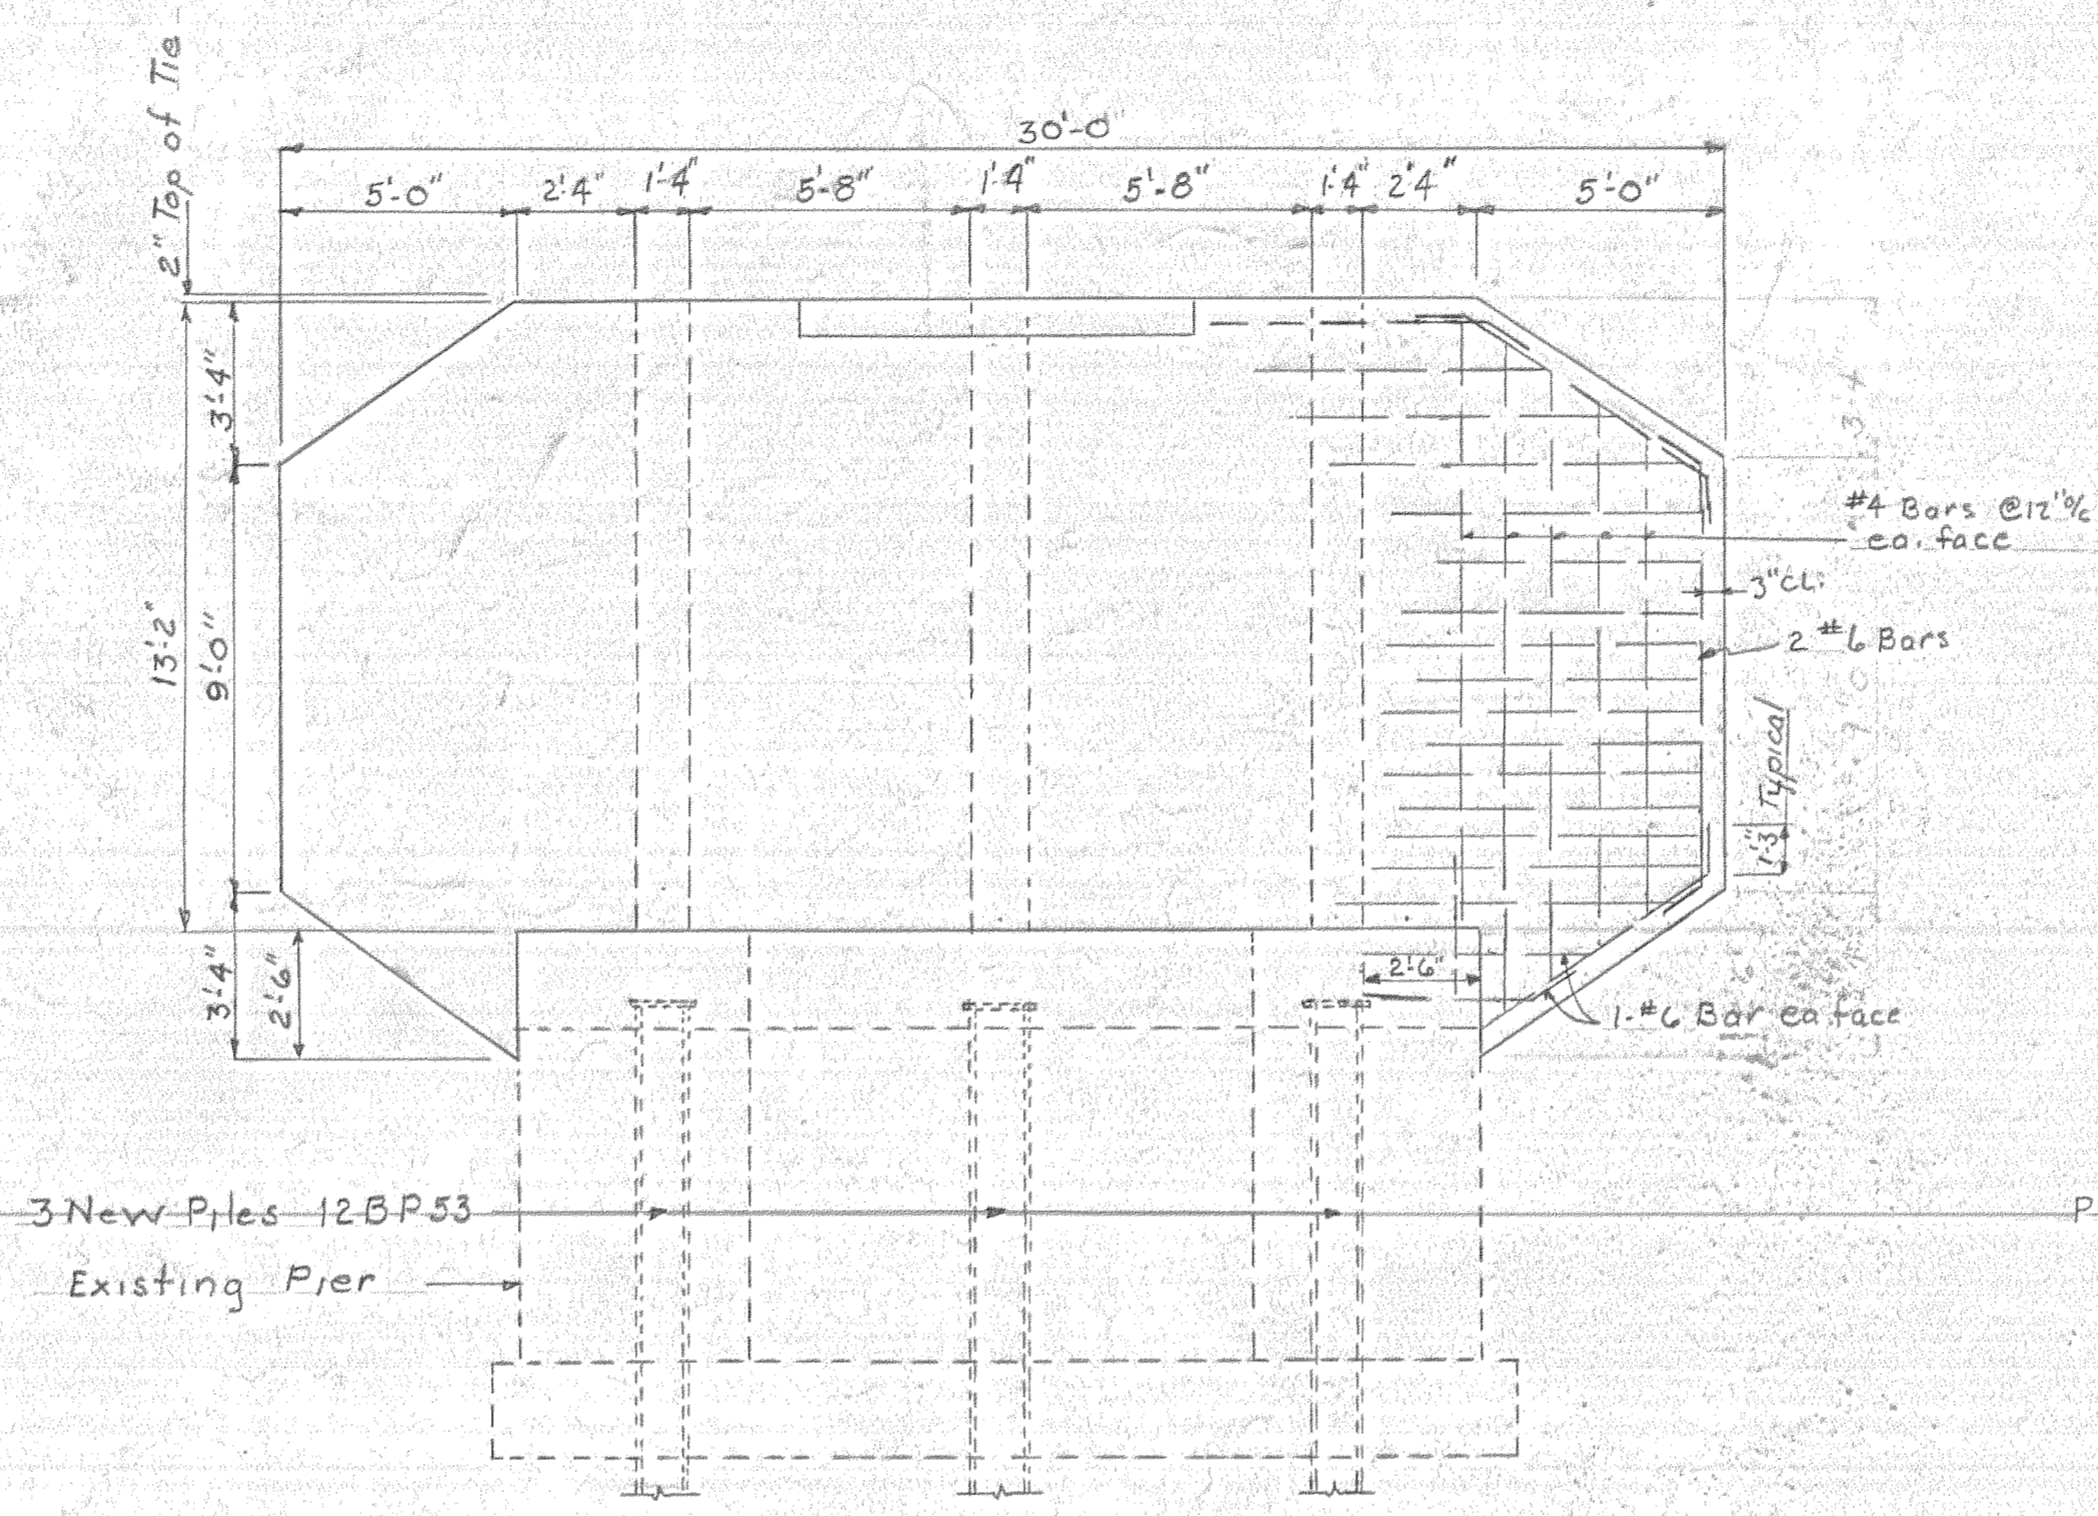


SECTION A-A
Scale 1/4" = 1'-0"

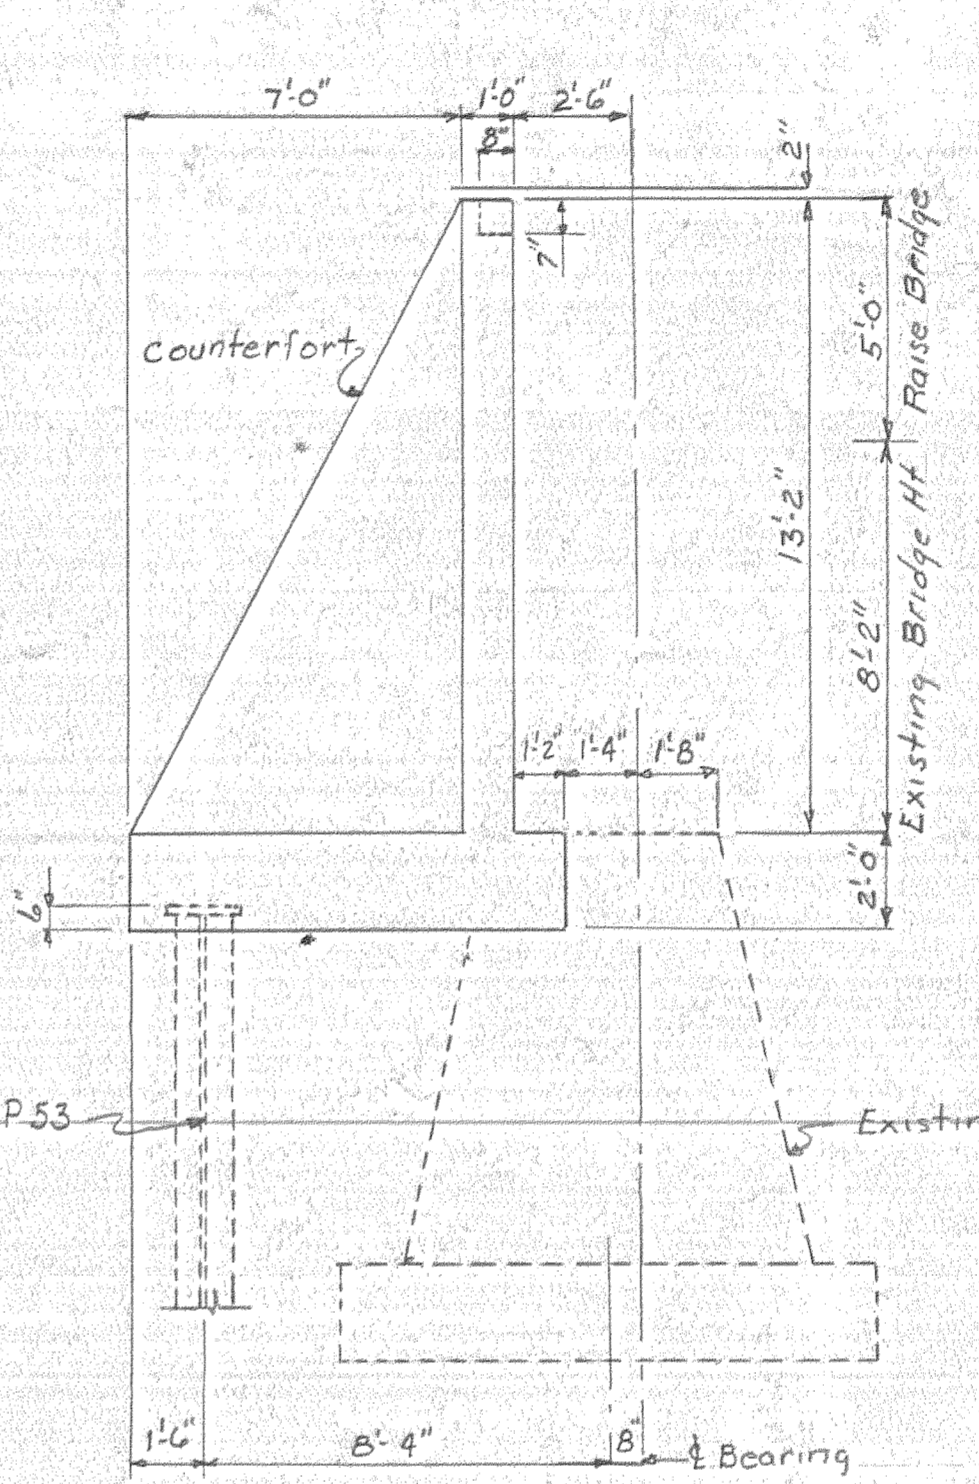


SECTION B-B
Scale 1/4" = 1'-0"

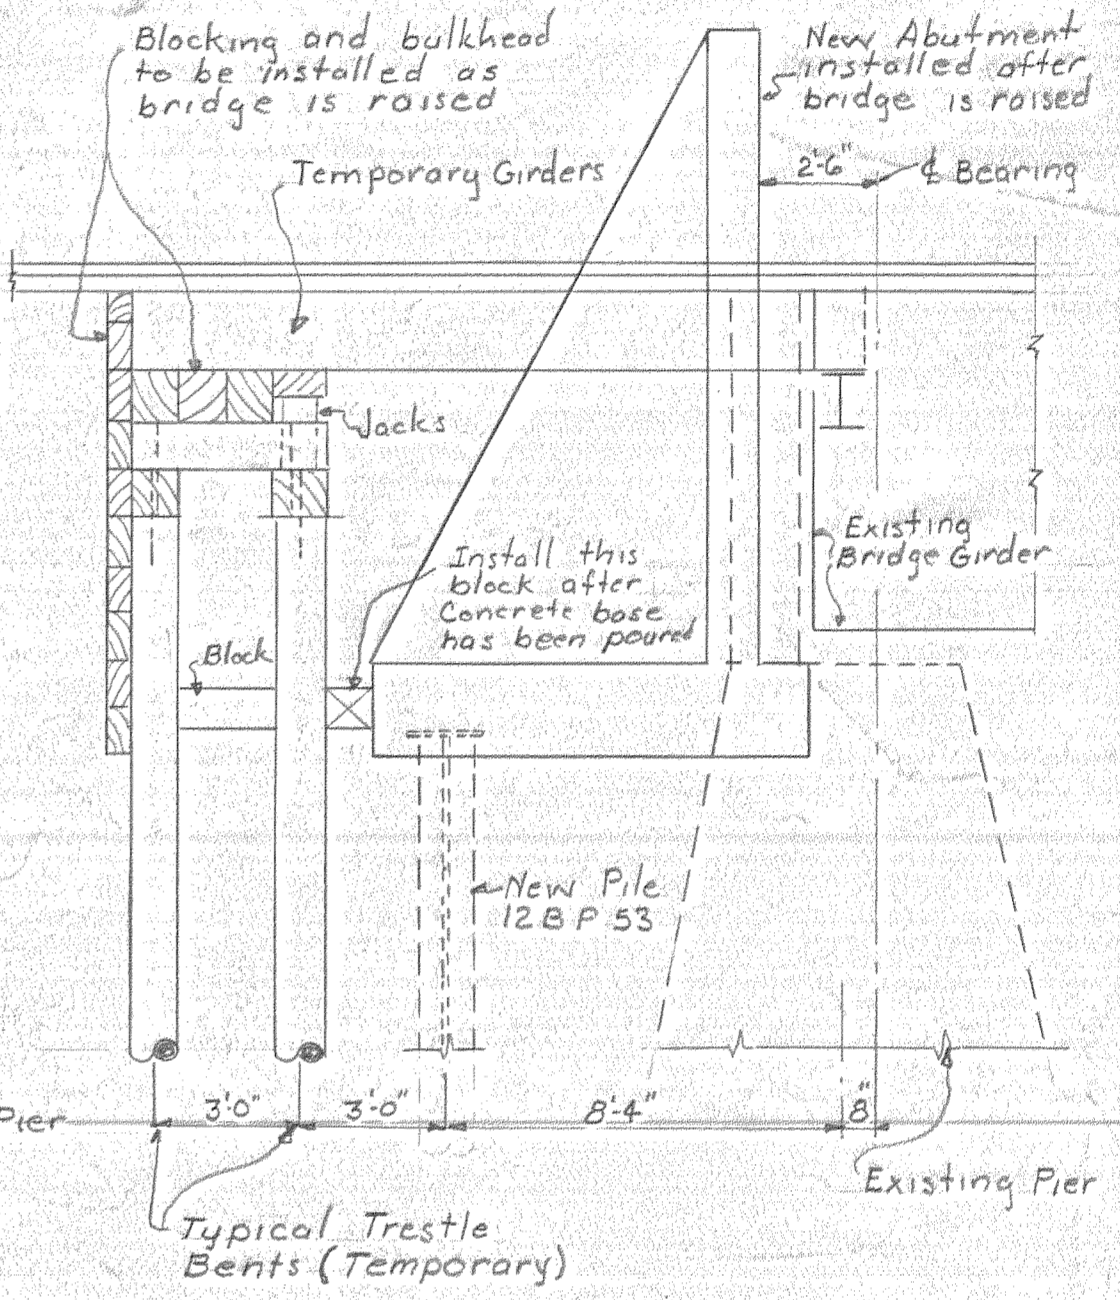


TEMPORARY SUPPORTS FOR
INSTALLATION OF NEW ABUTMENTS

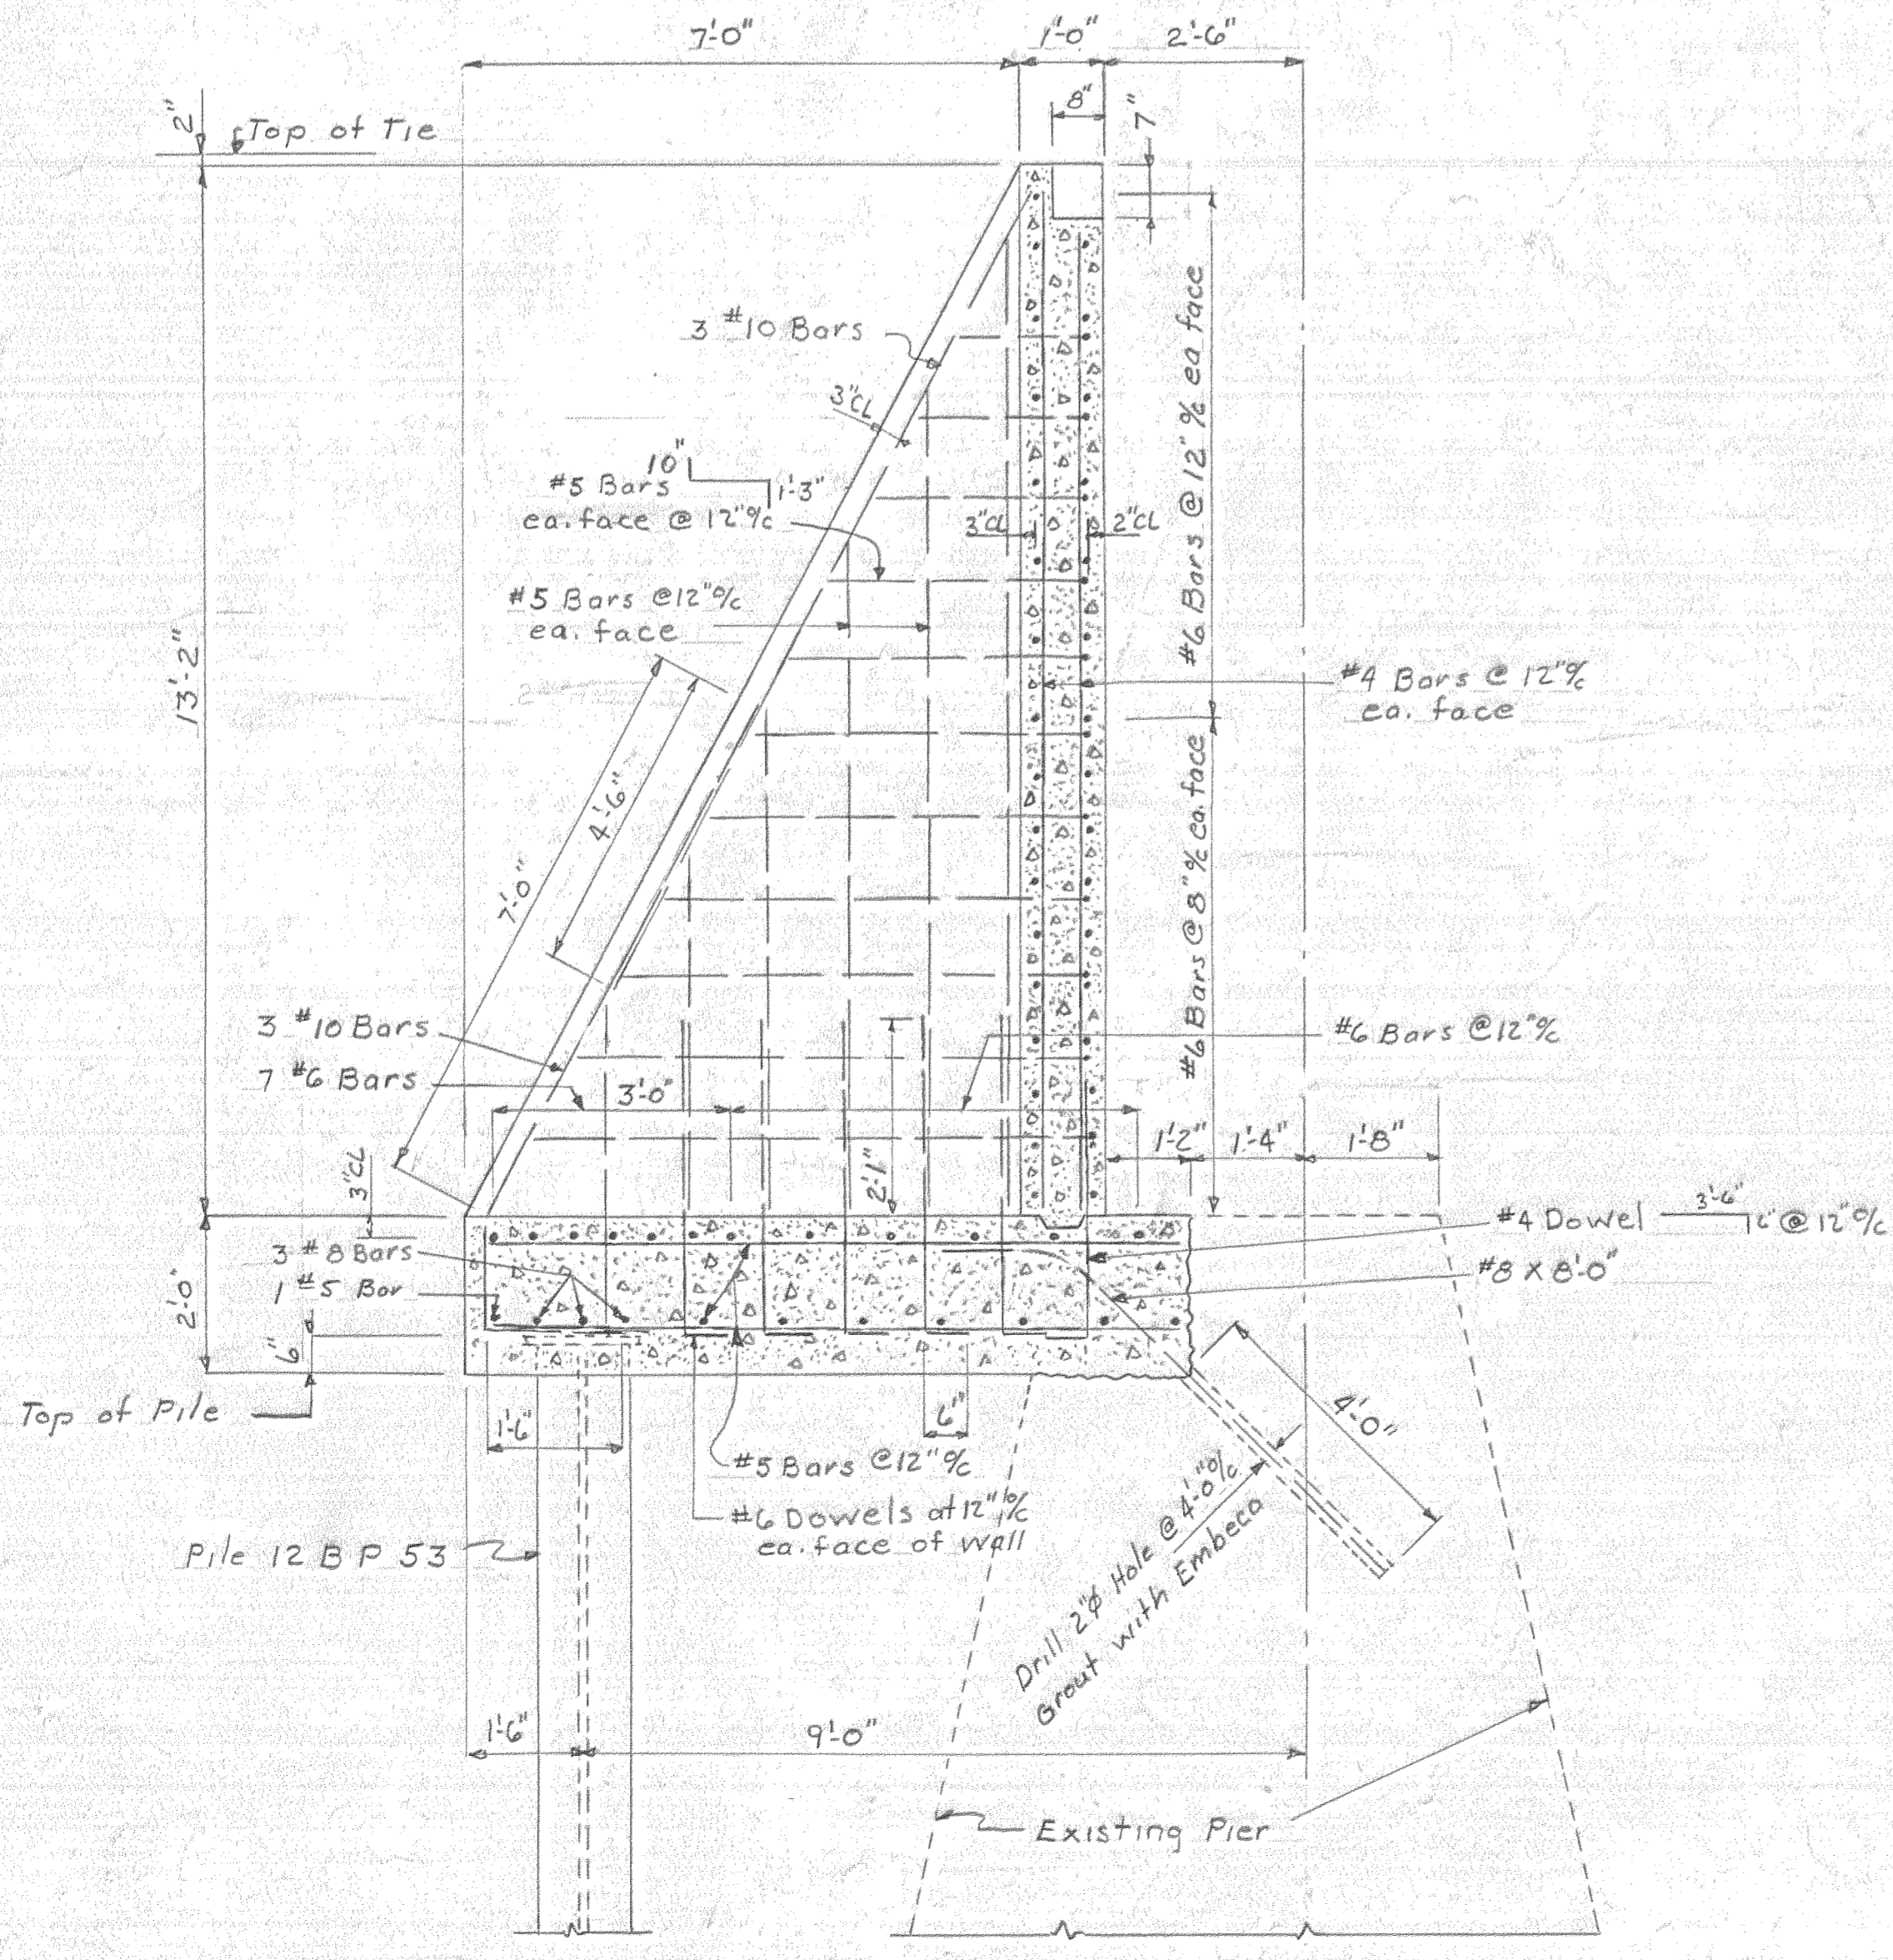

SECTION C-C
Scale 1/2" = 1'-0"

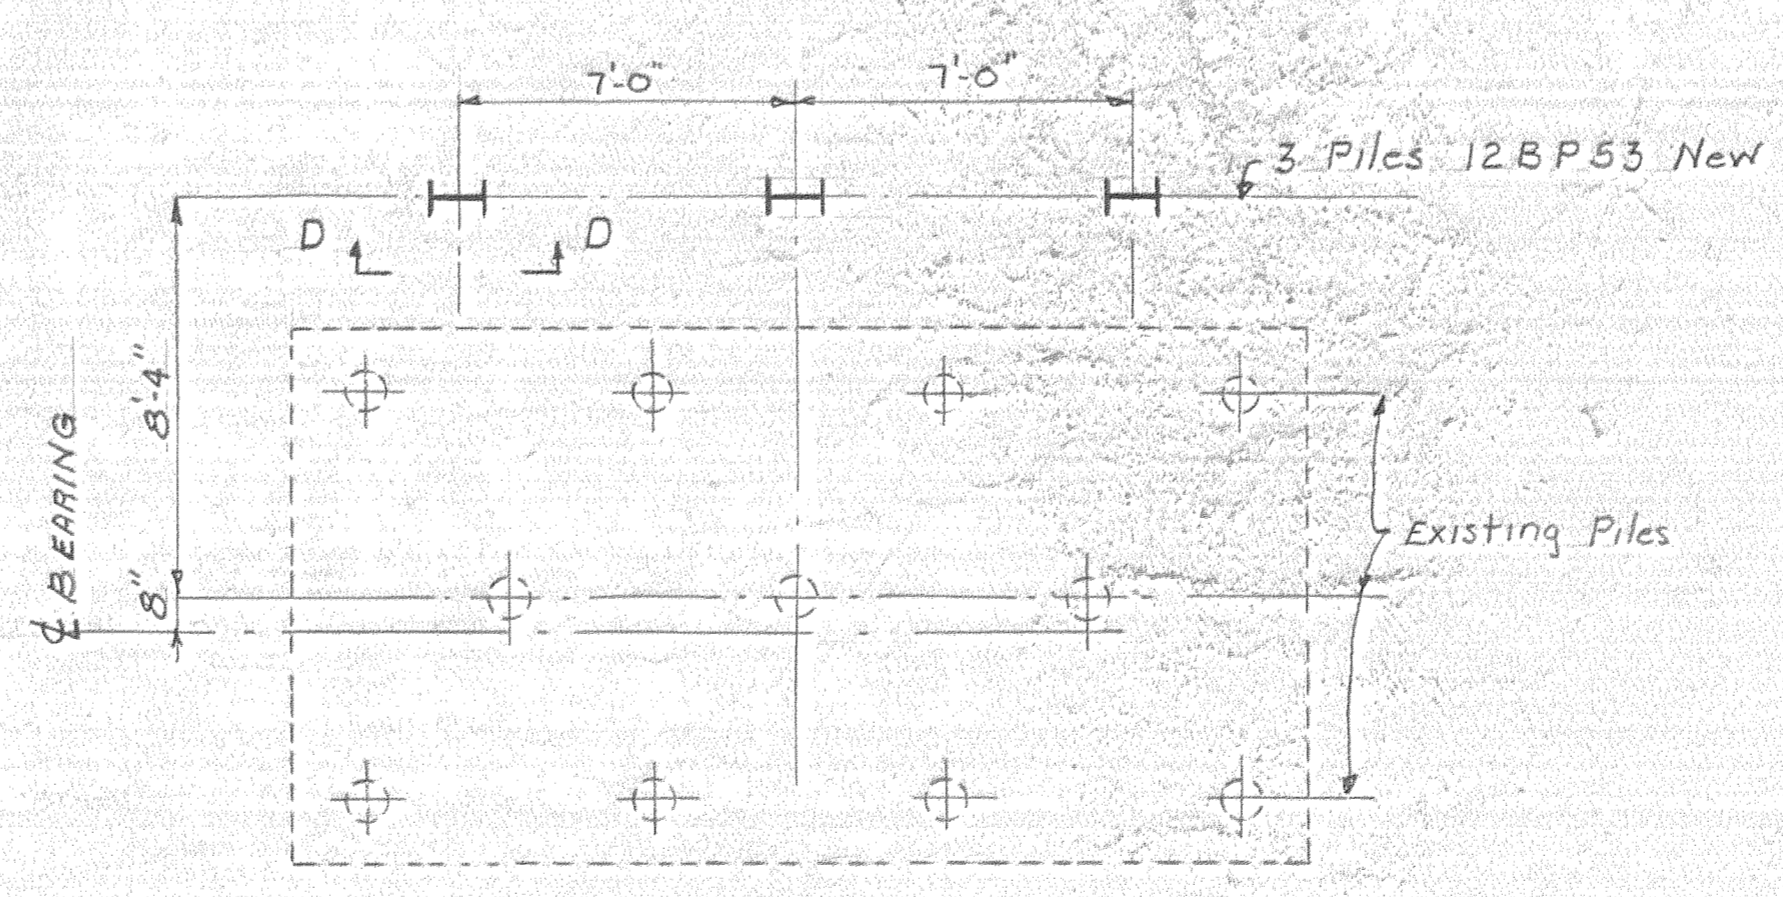


PILE PLAN
Scale 1/4" = 1'-0"

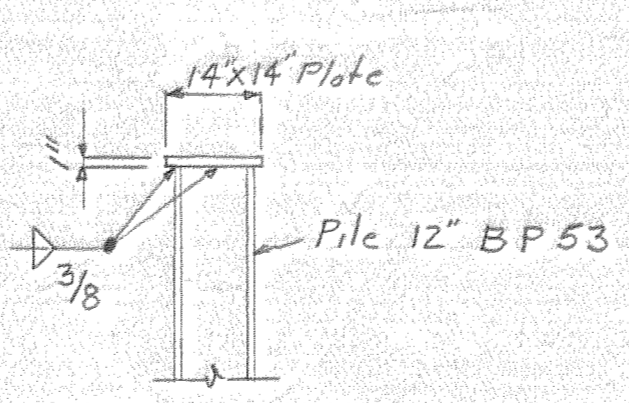

SECTION D-D
Scale 1/2" = 1'-0"

TYPICAL KEY
WALL AND COUNTERFORT

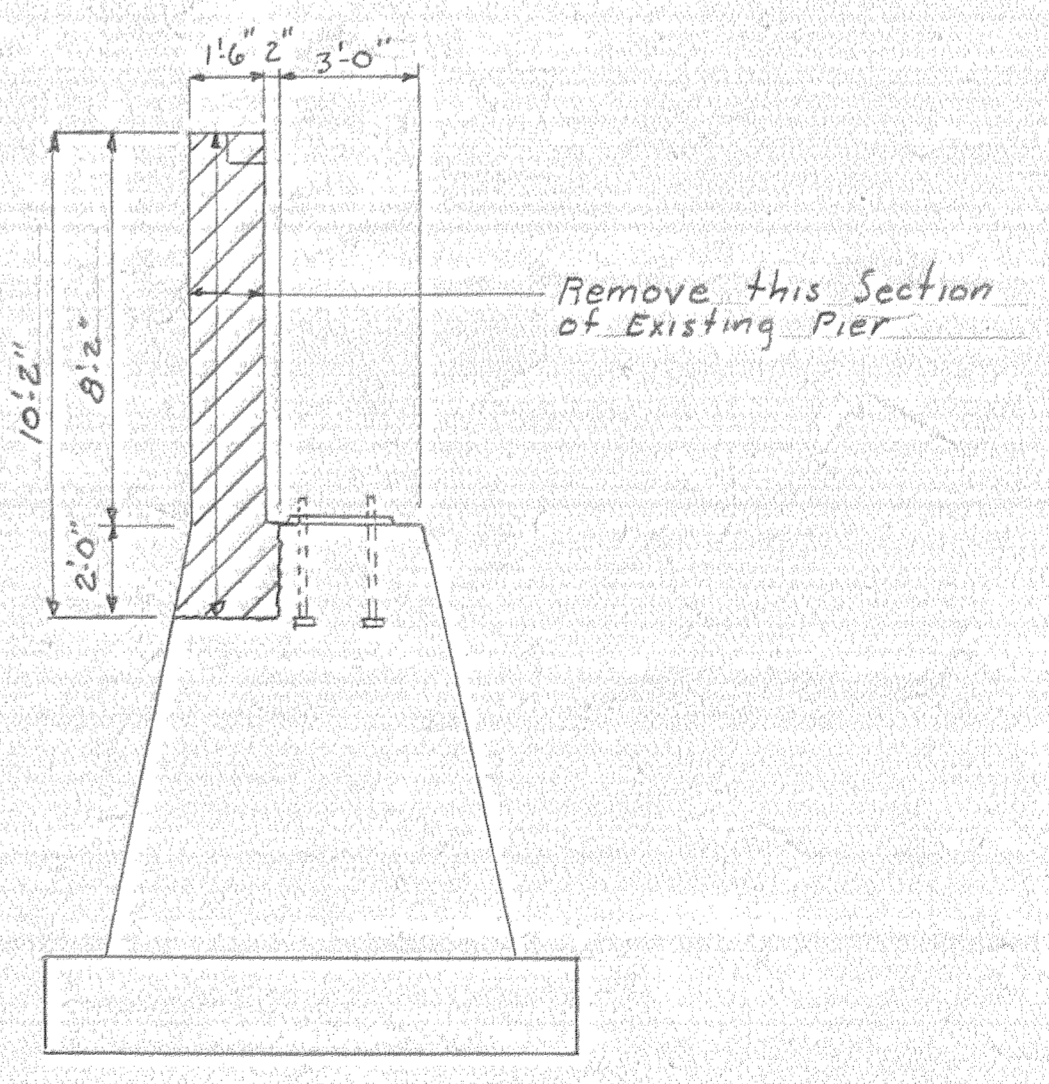

SECTION OF EXISTING PIER

NOTES
Concrete 2500 #4
Reinforcing Steel intermediate grade
Both abutments are similar
New Piles 12 BP 53 X 40'-0" long

EARL AND WRIGHT, INC. CONSULTING ENGINEERS 49 FREMONT ST. SAN FRANCISCO, CALIFORNIA	UNITED STATES DEPARTMENT OF THE INTERIOR THE ALASKA RAILROAD OFFICE OF THE CHIEF ENGINEER, ANCHORAGE	
	DESIGNED BY <i>M. Watt</i> DRAWN BY <i>M. Watt</i> CHECKED BY <i>W.W. Hayes</i> SUBMITTED BY <i>W.W. Hayes</i> DATE <i>August 15, 1968</i>	PORTAGE ALASKA BRIDGE 64.7 NEW ABUTMENT
EARL AND WRIGHT, INC. BY <i>CE 488-E July 7, 1968</i>	RECOMMENDED BY APPROVED BY	DATE <i>12 Aug 1968</i> SHEET NO. <i>1</i> OF <i>1</i> FILE <i>64.7</i>